

1. VERIFY W/ OWNER SALVAGED ITEMS (STORE & PROTECT)
2. REFER TO PREPARED DRAWINGS FOR ADDITIONAL ITEMS THAT MAY IMPACT DEMOLITION NOT SHOWN IN THIS FLOOR PLAN
3. VERIFY LOCATION OF ELECTRICAL, PLUMBING AND MECHANICAL UTILITIES. LOCATE AND PROTECT UTILITIES TO REMAIN. DISCONNECT, REMOVE AND CAP DESIGNATED UTILITIES WITHIN THE DEMOLITION AREA
4. PROVIDE STRUCTURAL SHORING REQUIRED TO MAINTAIN THE STRUCTURAL INTEGRITY OF THE CONSTRUCTION AREA AND IF ENDANGERED, CEASE OPERATIONS AND NOTIFY ARCHITECT IMMEDIATELY. DO NOT RESUME OPERATIONS UNTIL CORRECTIVE MEASURES HAVE BEEN TAKEN.
5. FIELD VERIFY IF CONCRETE FLOOR SLAB IS POST TENSIONS, PRETENSIONED OR STANDARD PRIOR TO CUTTING. FOLLOW INDUSTRY STANDARDS TO PROTECT SLAB REINFORCEMENT
6. THIS PLAN DEPICTS THE WORK OBSERVED VIA PHOTO RECORDS FOR DEMOLITION ACTIVITY TO THE EXISTING STRUCTURE PRIOR TO PERFORMED WORK BY OWNER AS ARCHITECT OF RECORD WAS NOT PRESENT DURING THE ORIGINAL CONSTRUCTION ACTIVITY



Contractor shall exercise the responsibility with architect in securing latest approved drawings prior to actually executing work

NO./REVISION/DATE

1 city resubmittal 4-20-20


JOHN A. SALAT ARCHITECTS

22386 Woodgrove Road, Lake Forest, CA 92630
PH 949-235-4847 email: freegwin@earthlink.net
zenarchitect.com

architect


GOODING RESIDENCE
ROOM ADDITION/REMODEL
OWNER DEMO PLANS

OWNER/SITE ADDRESS:
CONTACT: Kurt Gooding
 24722 Jeremiah DR.
 Dana Point, CA 92629
 (949) 302-1070 Email: kurt.gooding@gmail.com

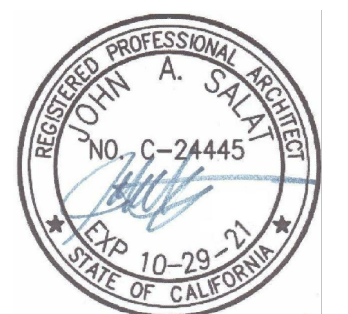

DRAWN _____
 J5
 CHECKED _____
 J5
 DATE _____
 SEE REVISION BOX ABOVE FOR DATE
 SCALE _____
 AS NOTED ON PLANS
 JOB NO. _____
 SHEET _____

A-2

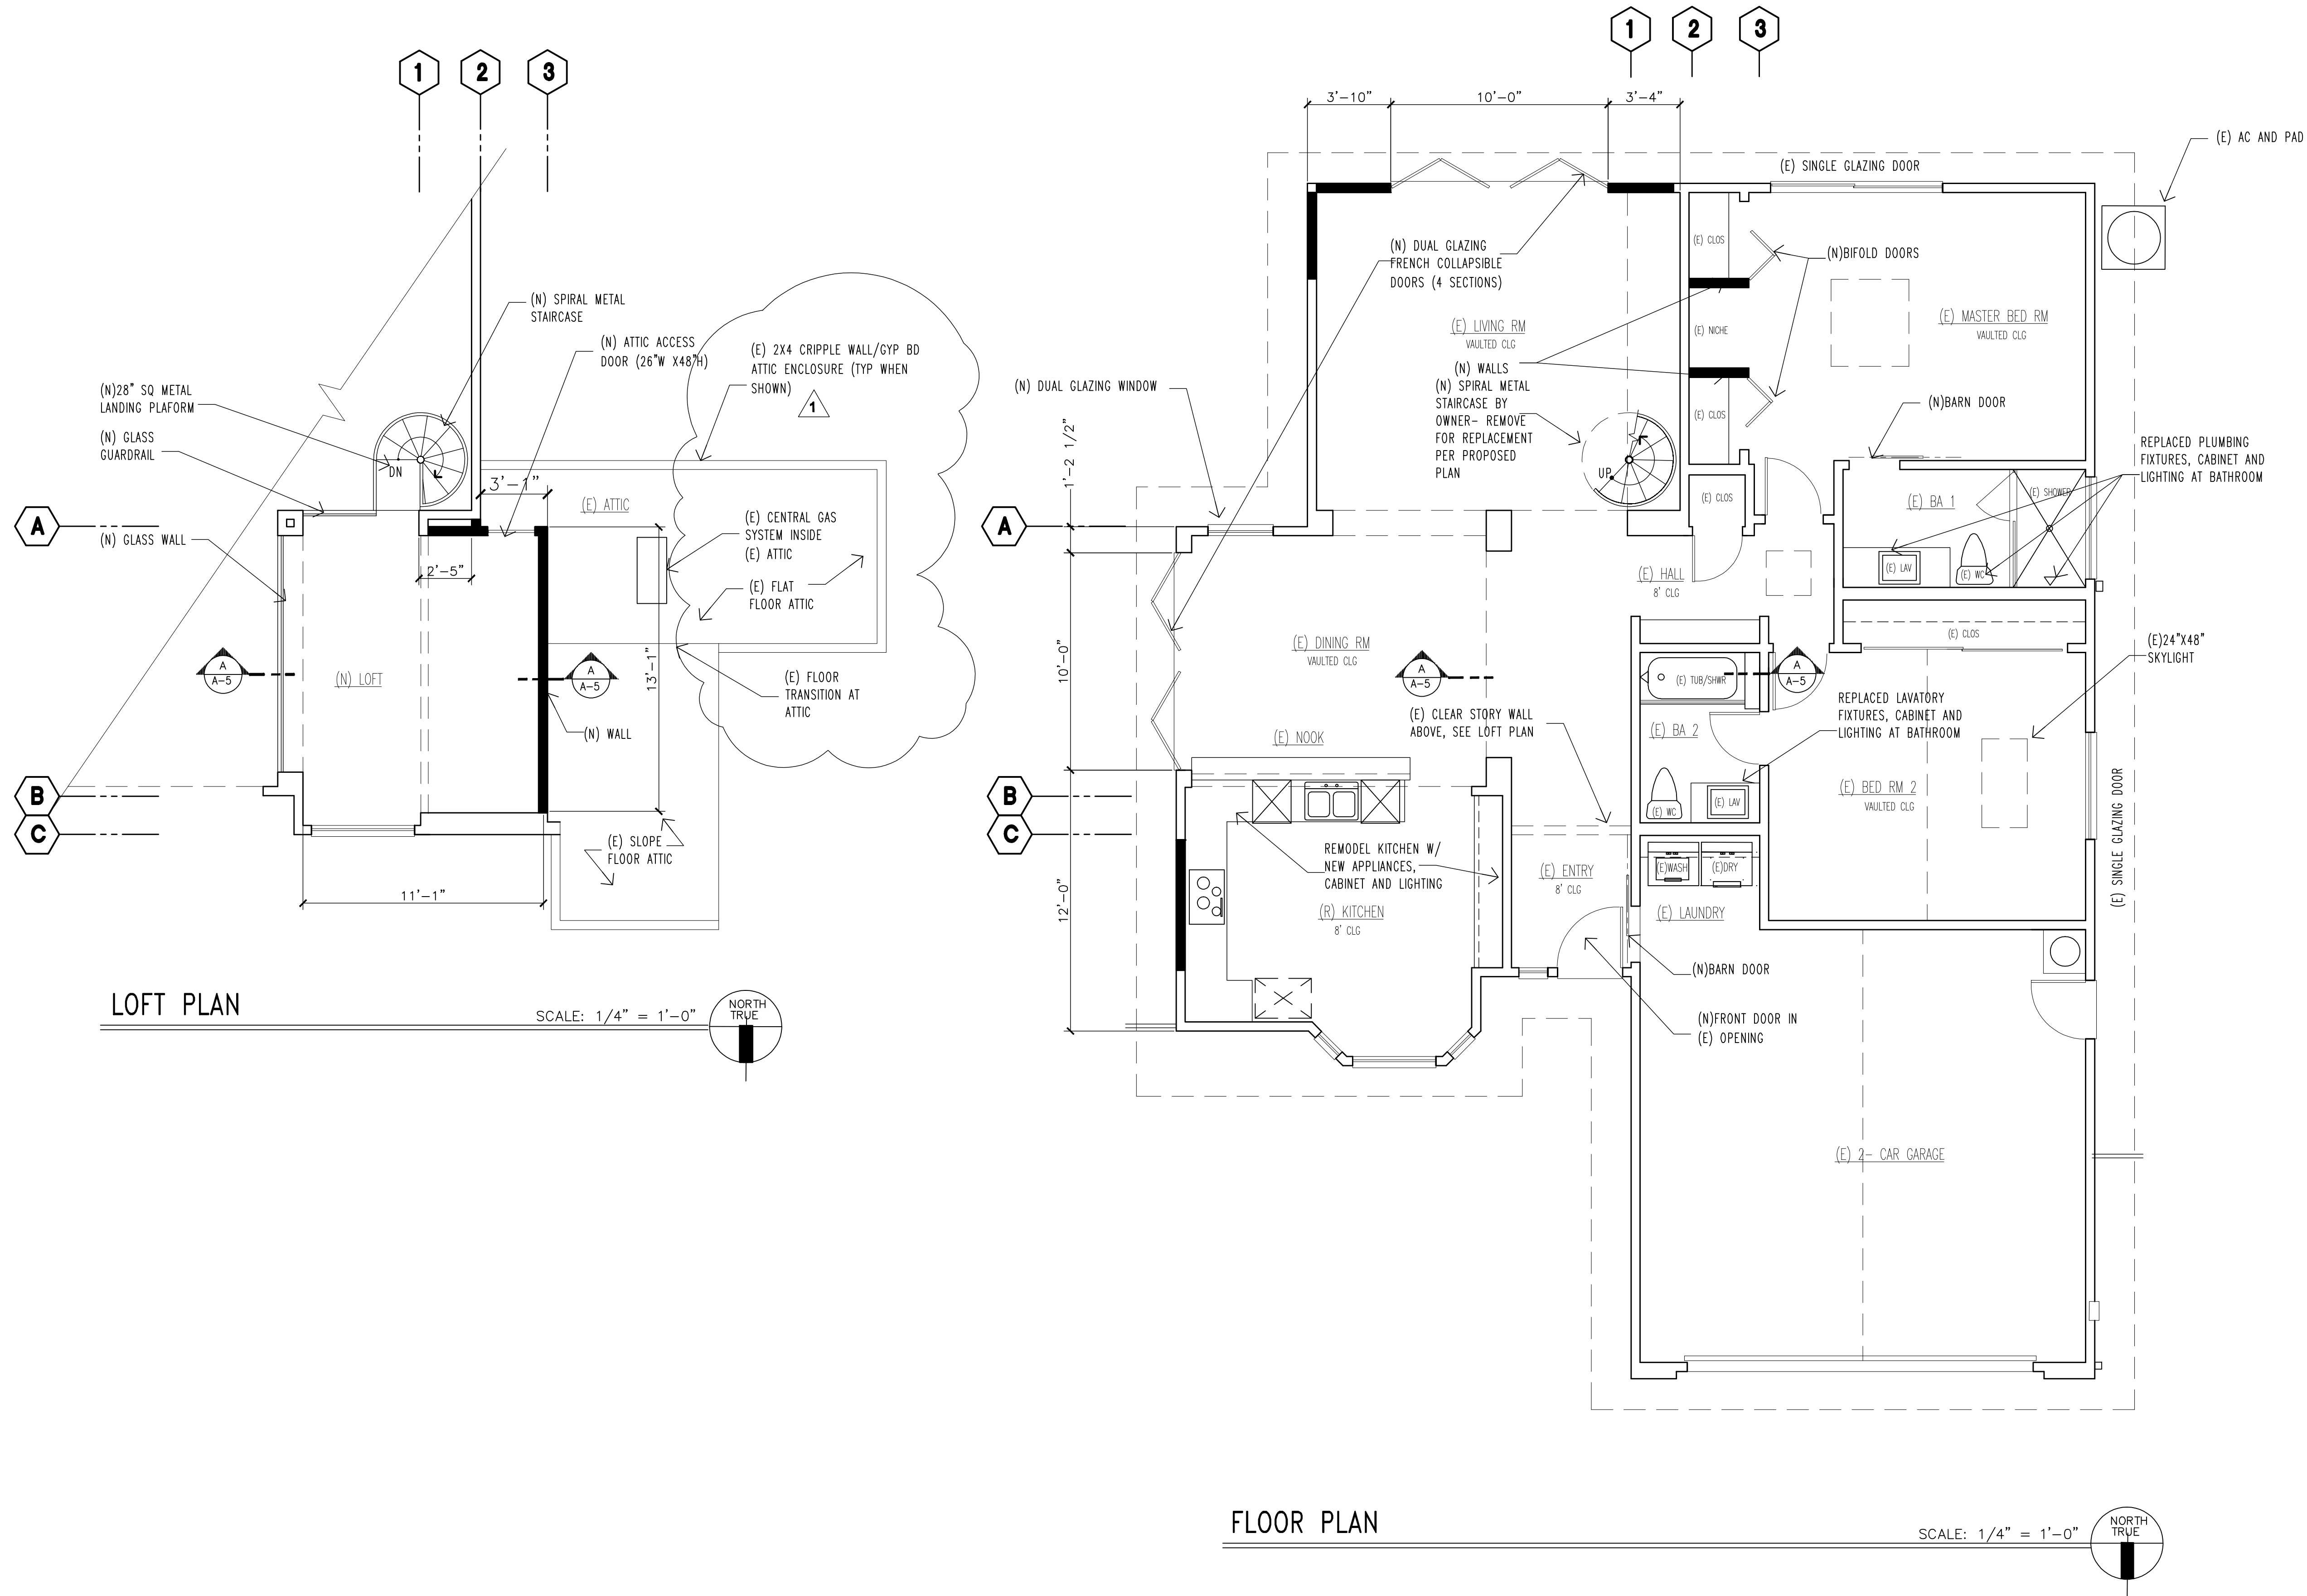

GENERAL PLAN NOTES

- THIS PLAN DEPICTS THE CURRENT INSTALLED WORK OBSERVED BY ARCHITECT AS AN RECORD PLAN OF CURRENT ACTIVITY PRIOR TO ARCHITECTS INVOLVMENT. FOR NEW WORK SEE PROPOSED PLANS OF SHEET A-4
- THE PLAN SHOWN ON THIS PAGE INDICATES BOTH NEW AND EXISTING CONDITIONS BY DESIGNATIONS OF (N) AND (E) OF SITE OBSERVATION AS (N) = NON PERMITTED WORK - SEE PROPSD PLAN SHEET A-4

Contractor shall exercise the responsibility with architect in securing latest approved drwgs. prior to actually executing work

NO./REVISION/DATE


1 city resubmittal 4-20-20

JOHN A. SALAT ARCHITECTS
22386 Woodgrove Road, Lake Forest, CA 92630
PH 949-235-4847 email: free@johnsalat.com

architect

GOODING RESIDENCE
ROOM ADDITION/REMODEL
SITE RECORD PLAN

OWNER/SITE ADDRESS:
CONTACT: Kurt Gooding
24722 Jeremiah DR.
Dana Point, CA 92629
(949) 302-1070 Email: kurt.gooding@gmail.com

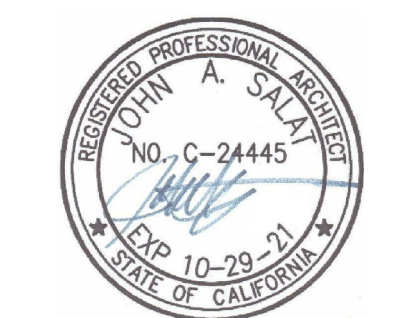

DRAWN
5
CHECKED
5
DATE
SEE REVISION BOX ABOVE FOR DATE
SCALE
AS NOTED ON PLANS
JOB NO.
SHEET

A-3

PREFAB STAIR NOTES

1. STAIR CONSTRUCTION, HANDRAIL & BALCONY GUARDRAIL ALL FABRICATED BY STAIR MANUFACTURER FOR MATCHING OF ACCESSORIES, TRIMS AND PICKETS. COMPLETE SHOP DRAWINGS SHALL PROVIDE INDICATING CONNECTION DETAILS INCLUDING FOUNDATION ENGINEERING -SUBMIT TO BLD'G DEPT. FOR SEPARATE APPROVAL FOR POSSIBLE MATCH: CONTACT MFOR info@paragonstairs.com DOWNTOWN SERIES PH. 888-939-3778
2. STAIR MANUFACTURE SHALL ENGINEER ENTIRE SUPER-STRUCTURE INCLUDING POST, TREADS, AND UPPER LANDING PLATFORM
3. SEE PLANS FOR RISERS & RUN - STAIR MANUFACTURE FIELD VERIFY DIMENSIONS PRIOR TO FABRICATION SPIRAL STAIR DIMENSION AND LAYOUT PER SECTION PER R311.7.10.1 FOR TREAD AND RISER SIZE AND WIDTH FOR WINDER CONDITION
4. STAIR CONSTRUCTION FOR HANDRAILS & GUARDRAILS SHALL BE ADEQUATE TO SUPPORT LOADS PER LINEAL FOOT AT A RIGHT ANGLE TO THE TOP RAIL. METAL VERTICAL PICKETS SPACED SO THAT A 4 IN. SPHERE CANNOT PASS THROUGH. PER CBC 1607.8.1 FABRICATION BY STAIR MANUFACTURER
5. THE LARGEST RISE OR RUN IN A FLIGHT OF STAIRS MAY NOT EXCEED THE SMALLEST BY 3/8". R311.7.10.1 SPIRAL STAIRS: WITH TREADS THAT ARE NARROW ON ONE END AND WIDER AT THE OTHER, ARE CALLED WINDER STAIRS. SPIRAL STAIRWAYS. SPIRAL STAIRWAYS ARE PERMITTED PROVIDED THE MINIMUM CLEAR WIDTH AT AND BELOW THE HANDRAIL SHALL BE 26 INCHES WITH EACH TREAD HAVING A 7-1/2-INCH MINIMUM TREAD DEPTH AT 12 INCHES FROM THE NARROWER EDGE. ALL TREADS SHALL BE IDENTICAL, AND THE RISE SHALL BE NO MORE THAN 9-1/2 INCHES. A MINIMUM HEADROOM OF 6 FEET 6 INCHES SHALL BE PROVIDE.

PUBLIC WORKS NOTES

1. THE EXISTING SITE DRAINAGE CONDITIONS ARE TO REMAIN AND NO DRAINAGE IMPROVEMENTS ARE PROPOSED.
2. ALL DRAINAGE SHALL BE MAINTAINED AND IN ACCORDANCE AND IN ACCORDANCE WITH THE 2019 CALIFORNIA BUILDING CODE AND DANA POINT MUNICIPAL CODE
3. SEE DETAIL 3 OF SHT D-4 FOR ACTUAL CONDITIONS OF (E) PATIO SLAB TO BUILDING EDGE THAT WHICH NO SITE IMPROVEMENTS ARE NEEDED.

ARCHITECTURAL NOTES


1. REFER TO DEMOLITION PLAN FOR (E) CONDITIONS OF ENTIRE STRUCTURE LAYOUT
2. REFER TO COVER SHEET FOR ADDITIONAL INFORMATION NOT SHOWN
3. SMOKE DETECTORS PER 2019 C.B.C., SEE MEP-2 PER NOTE 5, 6 & 7 OF SHEET SECTION 16 ELECTRICAL
4. CONTRACTOR SHALL FIELD VERIFY BOTH HORIZONTAL AND VERTICAL DIMENSIONS TO ENSURE PROPER FIT FOR ALL DETAILS-REPORT TO THE ARCHITECT IMMEDIATELY TO SECURE INSTRUCTIONS SHOULD INFORMATION BE INCORRECTLY NOTED
5. FOR INSULATION R-RATING IN WALLS AND ROOF, SEE BUILDING SECTION AND T-24 NOTES
6. FOR DEMO OR MEP PLANS, SEE SHEETS A-3, MEP-1 AND MEP-2
7. VERIFY ALL ALL FINISHES W/ OWNER PRIOR TO INSTALL- REFER TO DEMOLITION PLANS FOR ADDITIONAL ITEMS THAT MAY DISTURB EXISTING CONDITIONS THAT WILL REQUIRE REPAIR OR REPLACEMENT
8. REFER TO BLDG SECTION SHT A-5 FOR ADDITIONAL GENERAL NOTES NOT SHOWN
10. SHOWER STALL

(N) SHOWER STALL-FINISH PER INTERIOR DRAWINGS (N) FRAMELESS GLASS SHOWER DOOR AND ENCLOSURE TO BE SAFETY OR TEMPERED GLAZING (CRC R308.4) SHOWER FLOORS AND WALLS ABOVE SHOWER COMPARTMENTS SHALL BE FINISHED WITH A NONABSORBENT SURFACE TO A HEIGHT OF FULL HT OF 8" ABOVE THE FLOOR. (R307.2 CRC) CEMENT, FIBER-CEMENT, FIBER-MAT REINFORCED CEMENT, GLASS MAT GYPSUM OR FIBER-REINFORCED GYPSUM BACKERS SHALL BE USED AS A BASE FOR WALL TILE IN TUB AND SHOWER AREAS AND WALL AND CEILING PANELS IN SHOWER AREAS. (R702.4.2 CRC)- SEE MEP SHEET FOR PLUMBING LAYOUT AND 2/D-1 FOR DETAILS

11. PROVIDE A 36" DEEP LANDING AT EACH SIDE OF DOOR. THE SLOPE OF THE EXTERIOR LANDING SHALL NOT EXCEED 2% PER CODE CRC R311.3 AND AT THE LANDING SHALL BE NO MORE THAN 7.75" LOWER THAN THE TOP OF THE THRESHOLD WHERE THE DOOR DOES NOT SWING OVER THE LANDING PER CRC R311.3.1

PROPOSED LOFT PLAN

SCALE: 1/4" = 1'-0"

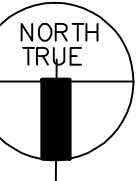

GLAZING NOTES AT LOFT (GLASS WALL/GLASS GUARDRAIL)

CRC CODES FOR GLAZING AND GUARDRAILS

CRC R106.1.1 SHOP DRAWINGS SHALL BE PREPARED BY GLAZING CONTRACTOR WITH ALL THE SPECS, CALCULATIONS AND ATTACHED DETAILS. GLAZING CONTRACTOR SHALL FIRST OBSERVED THE EXISTING GLAZING AND ATTACHMENTS BY FIELD VERIFY THE INTEGRITY AND VALIDITY THAT CAN DEMONSTRATE ANY OF THE EXISTING COMPONENTS OR MATERIALS AS POSSIBLE SALVAGEABILITY PRIOR TO REPLACEMENT OF SYSTEM USING THE CODE GUIDELINES BELOW. SECURE SEPARATE PERMIT WITH CITY PRIOR TO FABRICATION

CRC R308.4.3 Glazing in windows

Glazing in an individual fixed or operable panel that meets all of the following conditions shall be considered to be a hazardous location: The exposed area of an individual pane is larger than 9 square feet, The bottom edge of the glazing is less than 18 inches above the floor, The top edge of the glazing is more than 36 inches above the floor; and One or more walking surfaces are within 36 inches, measured horizontally and in a straight line, of the glazing.

Exceptions: Decorative glazing.

Where a horizontal rail is installed on the accessible side(s) of the glazing 34 to 38 inches above the walking surface. The rail shall be capable of withstanding a horizontal load of 50 pounds per linear foot without contacting the glass and have a cross-sectional height of not less than 1 1/2 inches. Outboard panes in insulating glass units and other multiple glazed panels where t edge of the glass is 25 feet or more above grade, a roof, walking surfaces or other horizontal[within 45 degrees (0.79 rad) of horizontal] surface adjacent to the glass exterior.

CRC R308.4.4 Glazing in guards and railings

Glazing in guards and railings, including structural baluster panels and nonstructural in-fill panels, regardless of area or he bottomheight above a walking surface shall be considered to be a hazardous location.

CBC Section for Glass in Handrails and Guards

CBC 2407.1 Materials: Glass used in a handrail, guardrail or a guard section shall be laminated glass constructed of fully tempered or heat-strengthened glass and shall comply with Category II or CPSC 16 CFR Part 1201 or Class A of ANSI Z97.1. Glazing in railing in-fill panels shall be of an approved safety glazing material that conforms to the provisions of Section 2406.1.1. For all glazing types, the minimum nominal thickness shall be 1/4 inch (6.4 mm).

CBC 2407.1.1 Loads: The panels and their support system shall be designed to withstand the loads specified in Section 1607.8. A design factor of four shall be used for safety.

CBC 2407.1.2 Support: Each handrail or guard section shall be supported by a minimum of three glass balusters or shall be otherwise supported to remain in place should one baluster panel fail. Glass balusters shall not be installed without an attached handrail or guard.


Exception: A top rail shall not be required where the glass balusters are laminated glass with two or more glass plies of equal thickness and the same glass type when approved by the building official. The panels shall be designed to withstand the loads specified in Section 1607.8.

ARCHITECTURAL SYMBOLS

- | | |
|----------------|------------------------------|
| (R)= REMODELED | (N) = NEW |
| | (N) 2X4 STUD WALLS @ 16" O.C |
| | (N) 2X6 STUD WALLS @ 16" O.C |
| | (E) 2X6 STUD WALLS TO REMAIN |
| | (E) 2X4 STUD WALLS TO REMAIN |

PROPOSED FLOOR PLAN

SCALE: 1/4" = 1'-0"

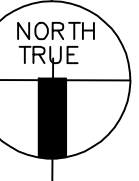

GENERAL PLANNING DEPT NOTE

The upper loft storage of building square foot adds 147 sf of non-habital space to the existing 1,419 dwelling. The new open loft storage does not become part of the dwelling square footage as is a utility storage space. Further s.f. and scope is per outline of sht A-1 FOR "AREA CALCULATIONS", "RECENT UNPERMITTED WORK" and "CONSTRUCTION HISTORY"

NO./REVISION/DATE


- | | |
|---|------------------------|
| 1 | city resubmittal 4-20- |
| 2 | city resubmittal 6-24- |

JOHN A. SALAT ARCHITECTS
22386 Woodgrove Road, Lake Forest, CA 92630
PH 949-235-4847 email: freerwinds@earthlink.net
zenarchitect.com

architect

GOODING RESIDENCE
ROOM ADDITION/REMODEL
SITE RECORD PLAN

OWNER/SITE ADDRESS:
CONTACT: Kurt Gooding
24722 Jeremiah DR.
Dana Point, CA 92629
(949) 302-1070 Email: kurt.gooding@gmail.com

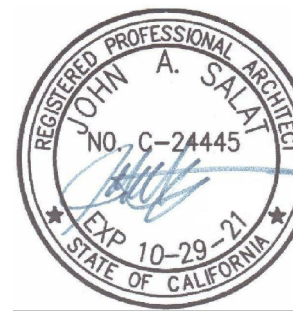

DRAWN

CHECKED

DATE

SEE REVISIONS FOR MORE FOR P&R

SCALE

AS NOTED ON PLANS

JOB NO.

SHEET

A-4

WINDOW/DOOR SCHEDULE

SEE FLOOR PLAN FOR DOOR/WINDOW KEYING

- NOTE: 1) ALL NEW GLAZING FOR DOORS AND WINDOWS SHALL MEET U AND SHGC OF 0.31 MAX AND 0.25 MAX RATING RESPECTIVELY (REFER TO T-24 FOR EXCEPTIONS IF APPLICABLE)
2) DOORS NOTED AS NEW ARE CURRENTLY INSTALLED (INFO FOR T-24 PURPOSE ONLY)
3) SEE EXTERIOR ELEVATION FOR DOOR AND WINDOW TYPES AND EXTRA NOTES NOT NOTED ON SCHEDULE

WINDOW TYPE/ REMARKS






WDW NO.	WDW #	(N)/(E)/(R)	SIZE(WIDTH X HEIGHT)	GLAZING TYPE	(N) =NEW WINDOW (E) =WDW TO REMAIN WINDOW SCHEDULE #
1	(E) WDW 1	(E)	1'-4" X 5'-0"	SINGLE PANE FIXED TEMPERED GLASS IN ALUMINUM FRAME	
	(E) WDW 2	(E)	1'-4" X 5'-0"	SINGLE PANE FIXED GLASS IN ALUMINUM FRAME	
	(E) WDW 3	(E)	4'-0" X 5'-0"	SINGLE PANE SLIDING GLASS IN ALUMINUM FRAME	
	(E) WDW 4	(E)	1'-4" X 5'-0"	SINGLE PANE FIXED GLASS IN ALUMINUM FRAME	
	(N) WDW 5	(E)	3'-0" X 5'-0"	SINGLE PANE SLIDING GLASS IN ALUMINUM FRAME	
1	(E) WDW 6	(E)	4'-8" X 1'-3"	SINGLE PANE TEMPERED SLIDING GLASS IN ALUMINUM FRAME	
	(E) WDW 7	(E)	5'-0" X 5'-6"	SINGLE PANE SLIDING GLASS IN ALUMINUM FRAME	
	(E) WDW 8	(E)	4'-6" X 2'-6"~4'-6"	VARIABLE TRAPEZOID SINGLE PANE FIXED GLASS IN ALUM FRAME (SEE EXTERIOR ELEVATION FOR PROFILE OF WINDOW)	

SKYLIGHTS TYPE/ REMARKS

SKYLIGHT NO.	SKYLIT #	(N)/(E)/(R)	SIZE(W X L)	GLAZING TYPE	LOCATION
	(E) SKY LT 1	(E)	2'-0" X 4'-0"	DUAL ACRYLIC DOME SKYLIGHT (1 ROOF LOCATION)	
	(E) SKY LT 2	(E)	4'-0" X 4'-0"	DUAL ACRYLIC DOME SKYLIGHT (1 ROOF LOCATION)	

DOOR TYPE/ REMARKS

DR NO.	DR #	(N)/(E)	SIZE(WIDTH X HEIGHT)	GLAZING TYPE	(N) =NEW DOOR IN (N) OPENING (E) =DOOR TO REMAIN DOOR SCHEDULE #
	(N) DR A	(N)	3'-0" X 6'-8"	SWING WOOD DOOR IN WOOD FRAME	
	(N) DR B	(N)	10'-0" X 6'-8"	BI-FOLD FRENCH DOOR WITH DUAL PANE TEMPERED GLASS IN METAL CLADE WOOD FRAME	
	(N) DR C	(N)	10'-0" X 6'-8"	BI-FOLD FRENCH DOOR WITH DUAL PANE TEMPERED GLASS IN METAL CLADE WOOD FRAME	
	(E) DR D	(E)	8'-0" X 6'-8"	SLIDING SINGLE PANE GLASS DOOR	
	(N) DR E	(N)	2'-6" X 6'-8"	WOOD BARN DOOR	
	(E) DR F	(N)	2'-8" X 6'-8"	PANEL WOOD DOOR (REPLACEMENT IN EXISTING INTERIOR WALL OPENING)	
	(E) DR G	(N)	2'-8" X 6'-8"	PANEL WOOD DOOR (REPLACEMENT IN EXISTING INTERIOR WALL OPENING)	
	(N) DR H	(N)	2'-8" X 6'-8"	PANEL WOOD DOOR (REPLACEMENT IN EXISTING INTERIOR WALL OPENING)	
	(N) DR J	(N)	2'-8" X 6'-8"	PANEL WOOD DOOR (REPLACEMENT IN EXISTING INTERIOR WALL OPENING)	
	(N) DR K	(N)	8'-0" X 6'-8"	PANEL WOOD WARDROBE DOOR	
1	(N) DR L	(E)	2'-6" X 6'-8"	BARN DOOR (REPLACE W/ (N) RATED DOOR W/ SELF CLOSURE HARDWARE FOR 20 MIN) -DR SHALL NOT BE LESS THAN 1-3/8" THICKNESS INCLUDING SELF-LATCHING DEVICES PER PLAN CRC 302.5.1	
	(E) DR M	(E)	16'-0" X 7'-0"	GARAGE DOOR	
	(E) DR N	(E)	2'-4" X 6'-8"	WOOD FLUSH DOOR	
	(N) DR O	(N)	3'-6" X 6'-8"	BI-FOLD WARDROBE DOOR	
	(E) DR P	(N)	3'-6" X 6'-8"	BI-FOLD WARDROBE DOOR	
1	(N) DR R	(N)	2'-6" X 5'-6"	WOOD ATTIC ACCESS DOOR	

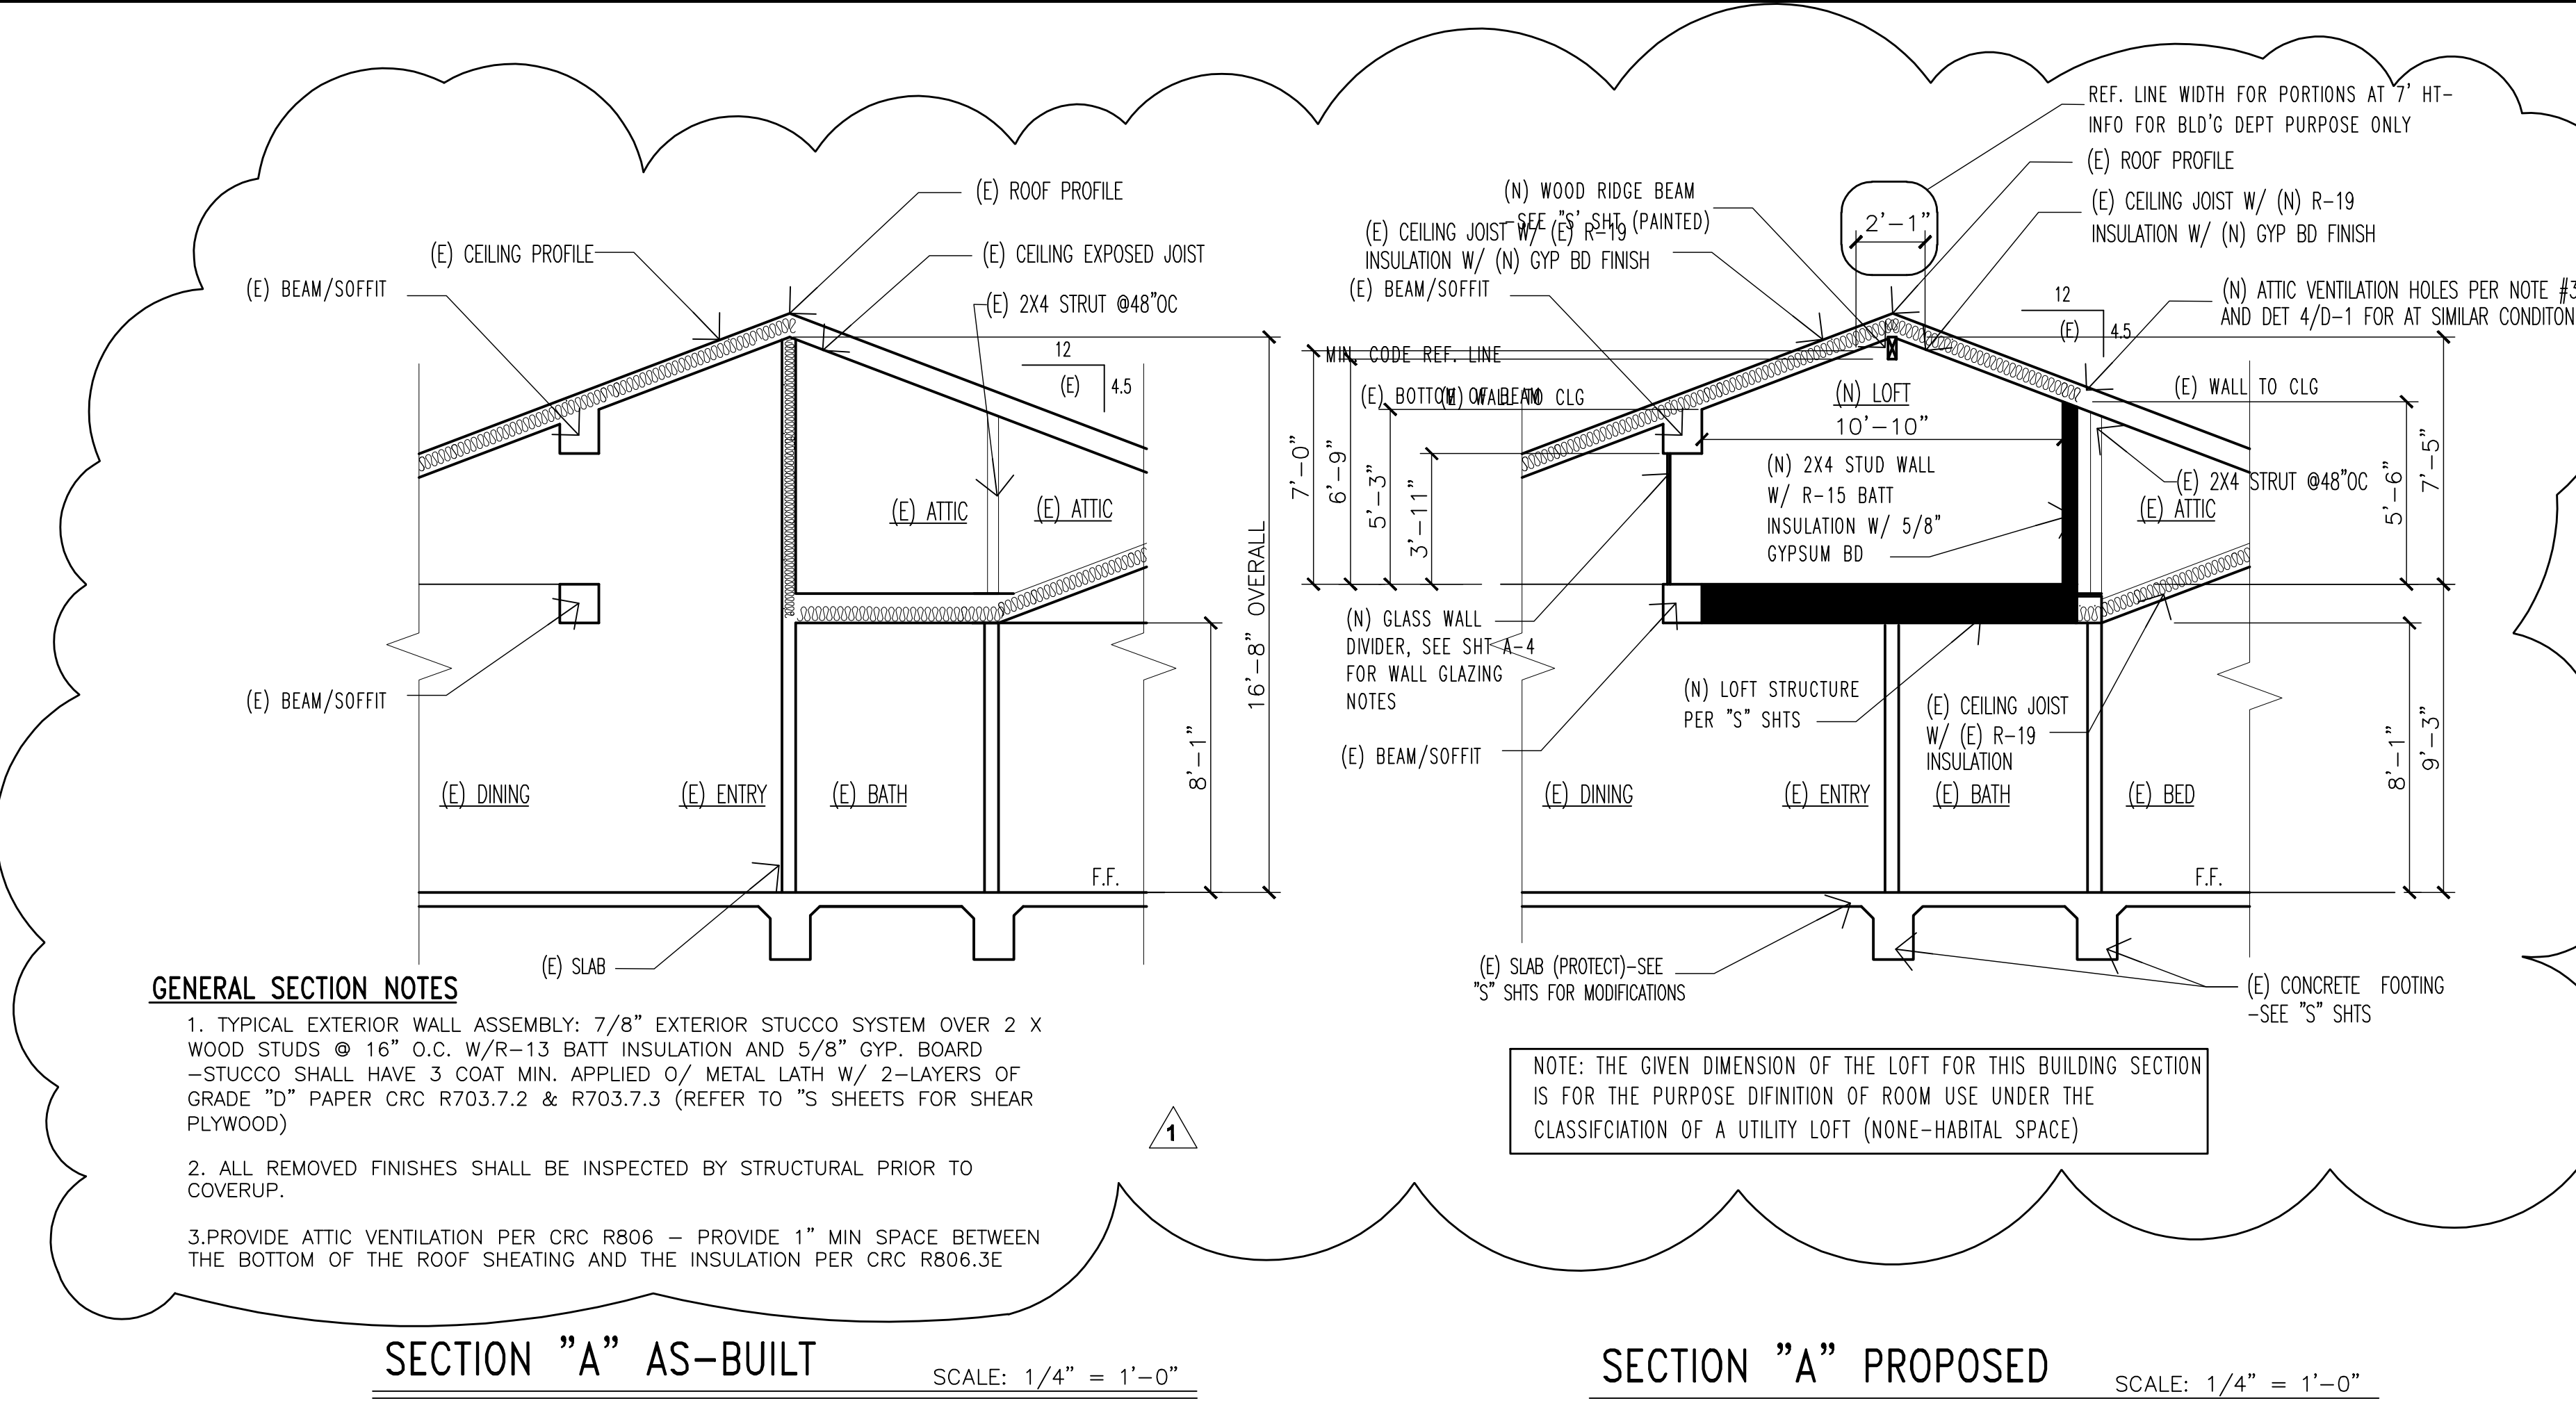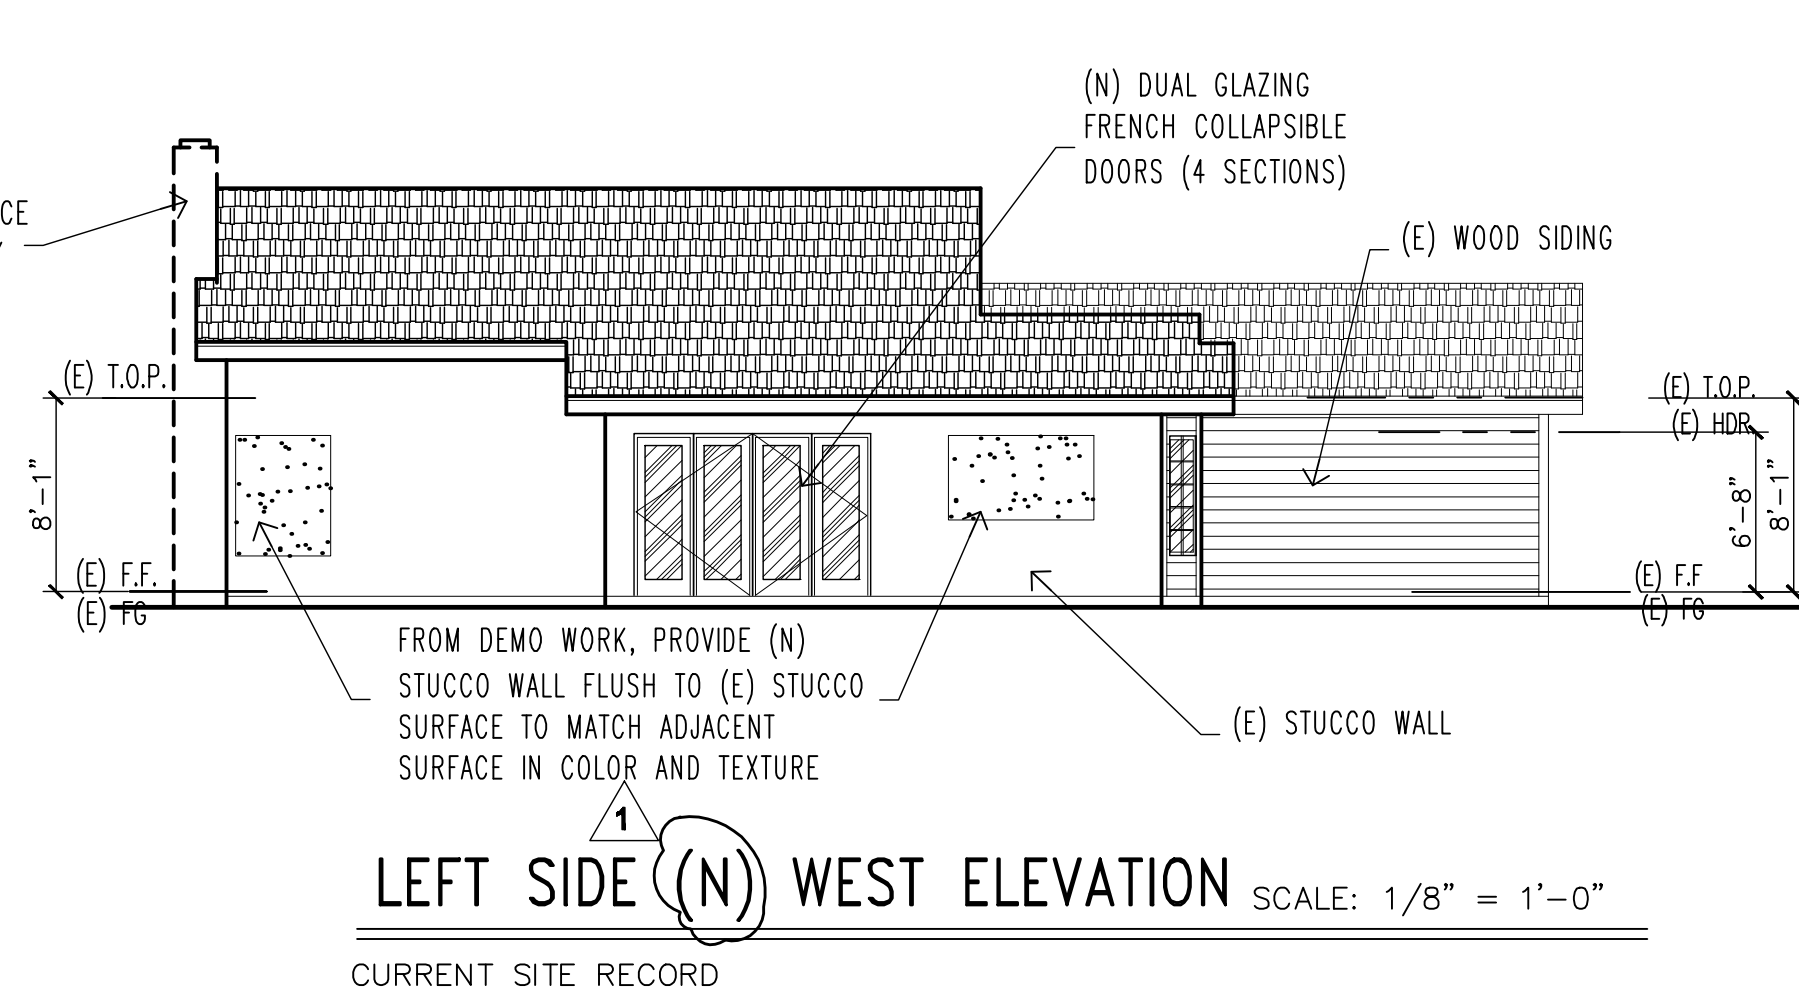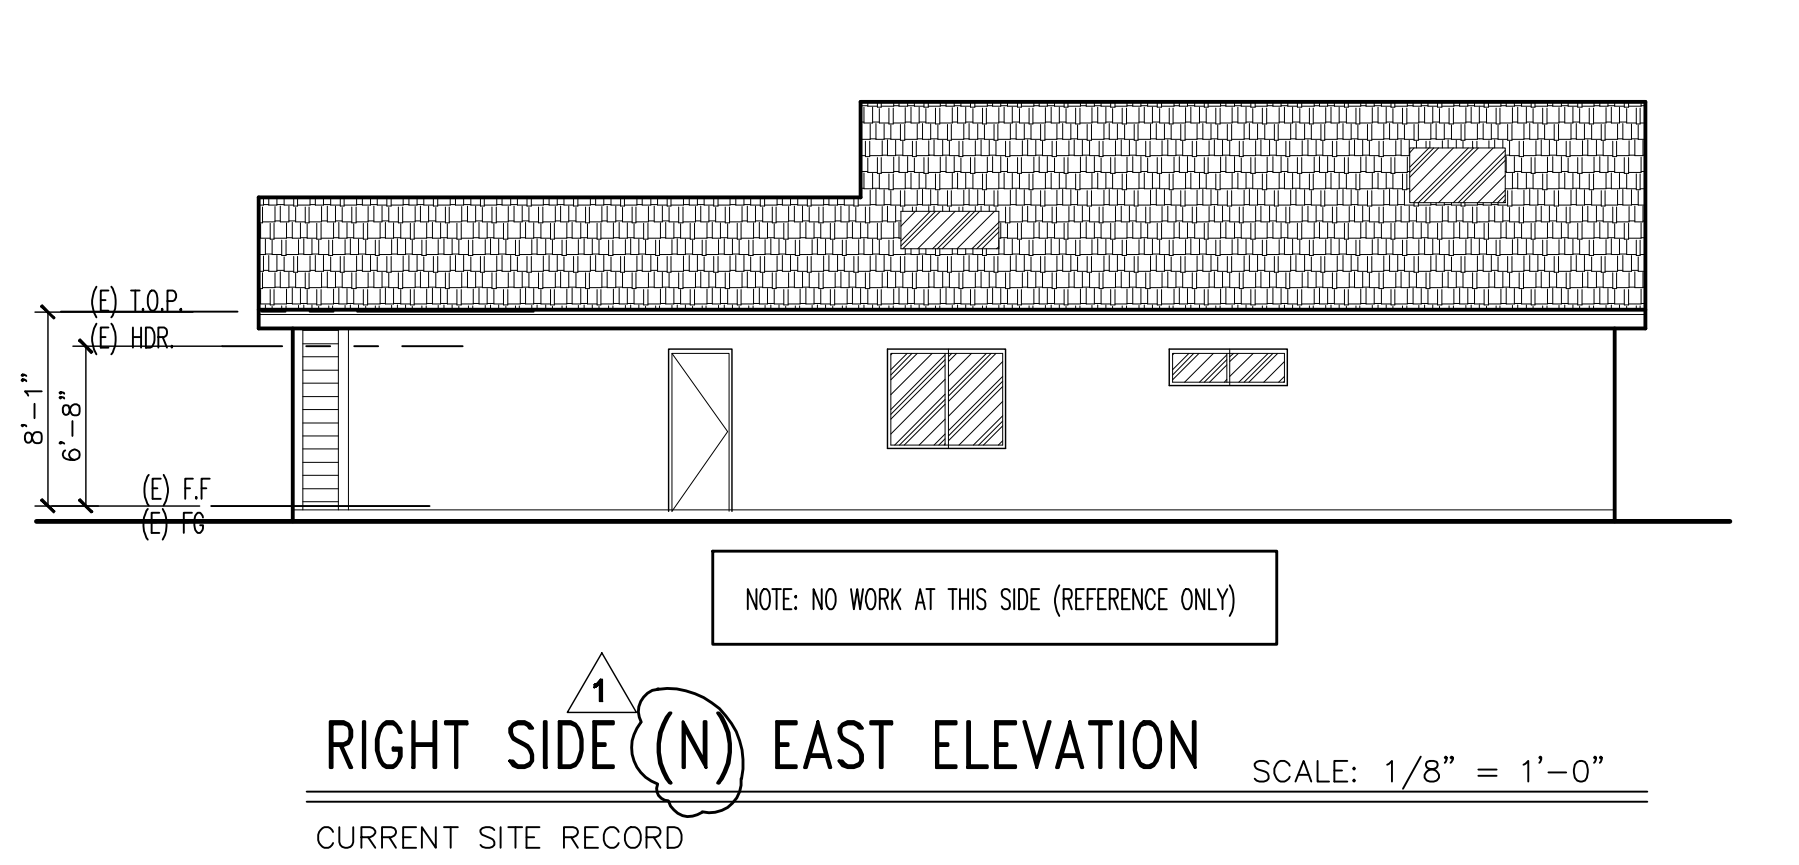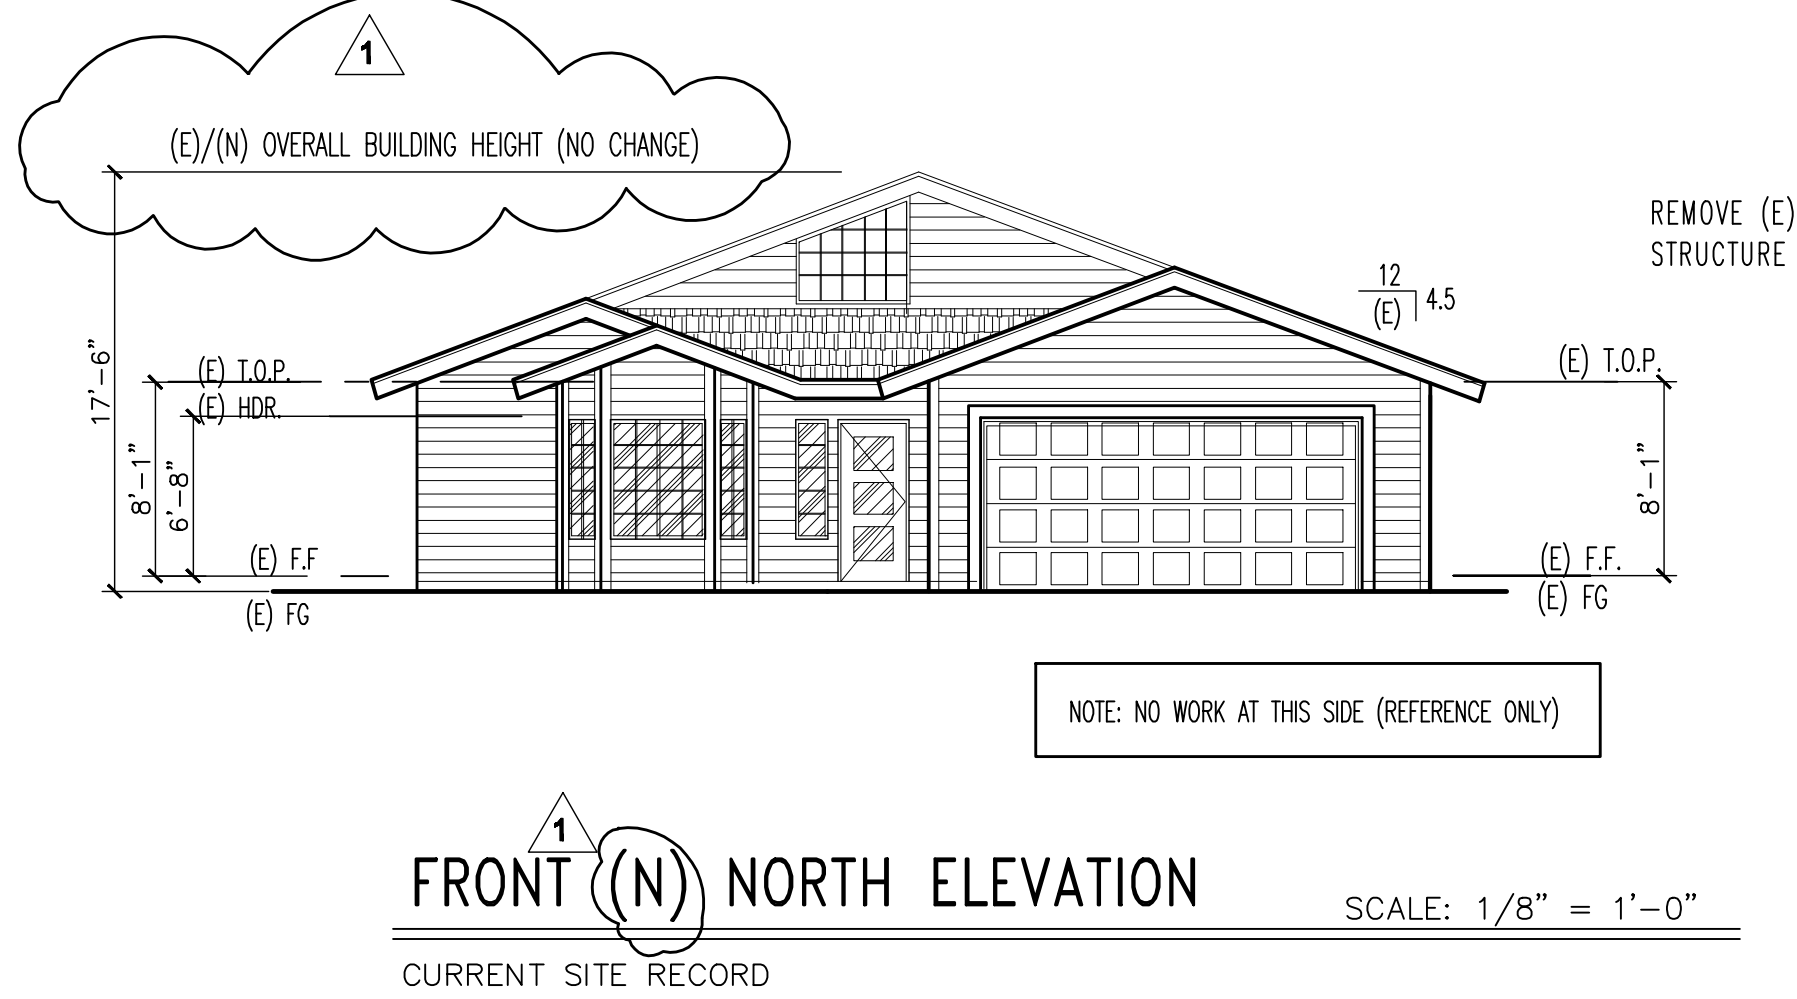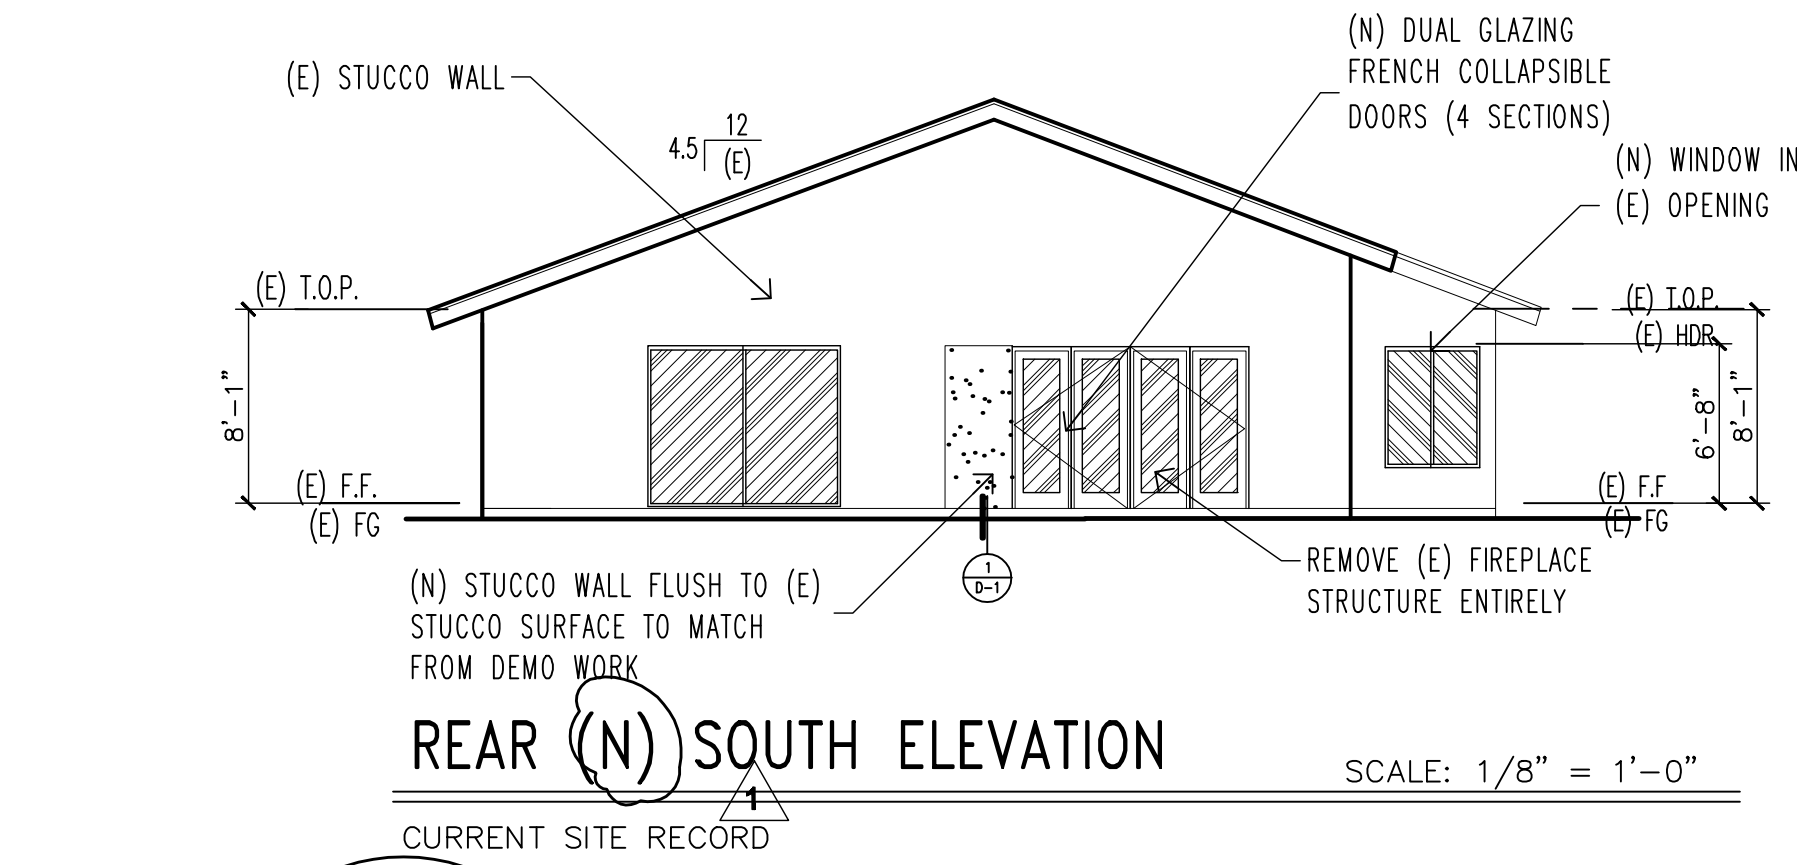

Contractor shall exercise the responsibility with architect in securing latest approved drawings prior to actually executing work

NO./REVISION/DATE


1 city resubmittal 4-20-20

JOHN A. SALAT ARCHITECTS
22386 Woodgrove Road, Lake Forest, CA 92630
PH 949-235-4847 email: freeraywinds@earthlink.net
zenarchitect.com

architect

GOODING RESIDENCE
ROOM ADDITION/REMODEL
proposed elevations
and sections

OWNER/SITE ADDRESS:
CONTACT: Kurt Gooding
24722 Jeremiah DR.
Dana Point, CA 92629
(949) 302-1070 Email: kurt.gooding@gmail.com

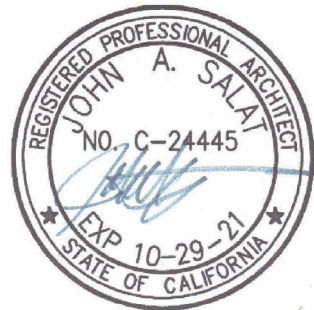

DRAWN

CHECKED

DATE

SEE REVISION BOX ABOVE FOR DATE

SCALE





AS NOTED ON PLANS

JOB NO.

SHEET

A-5

1 OF 12 SHEETS

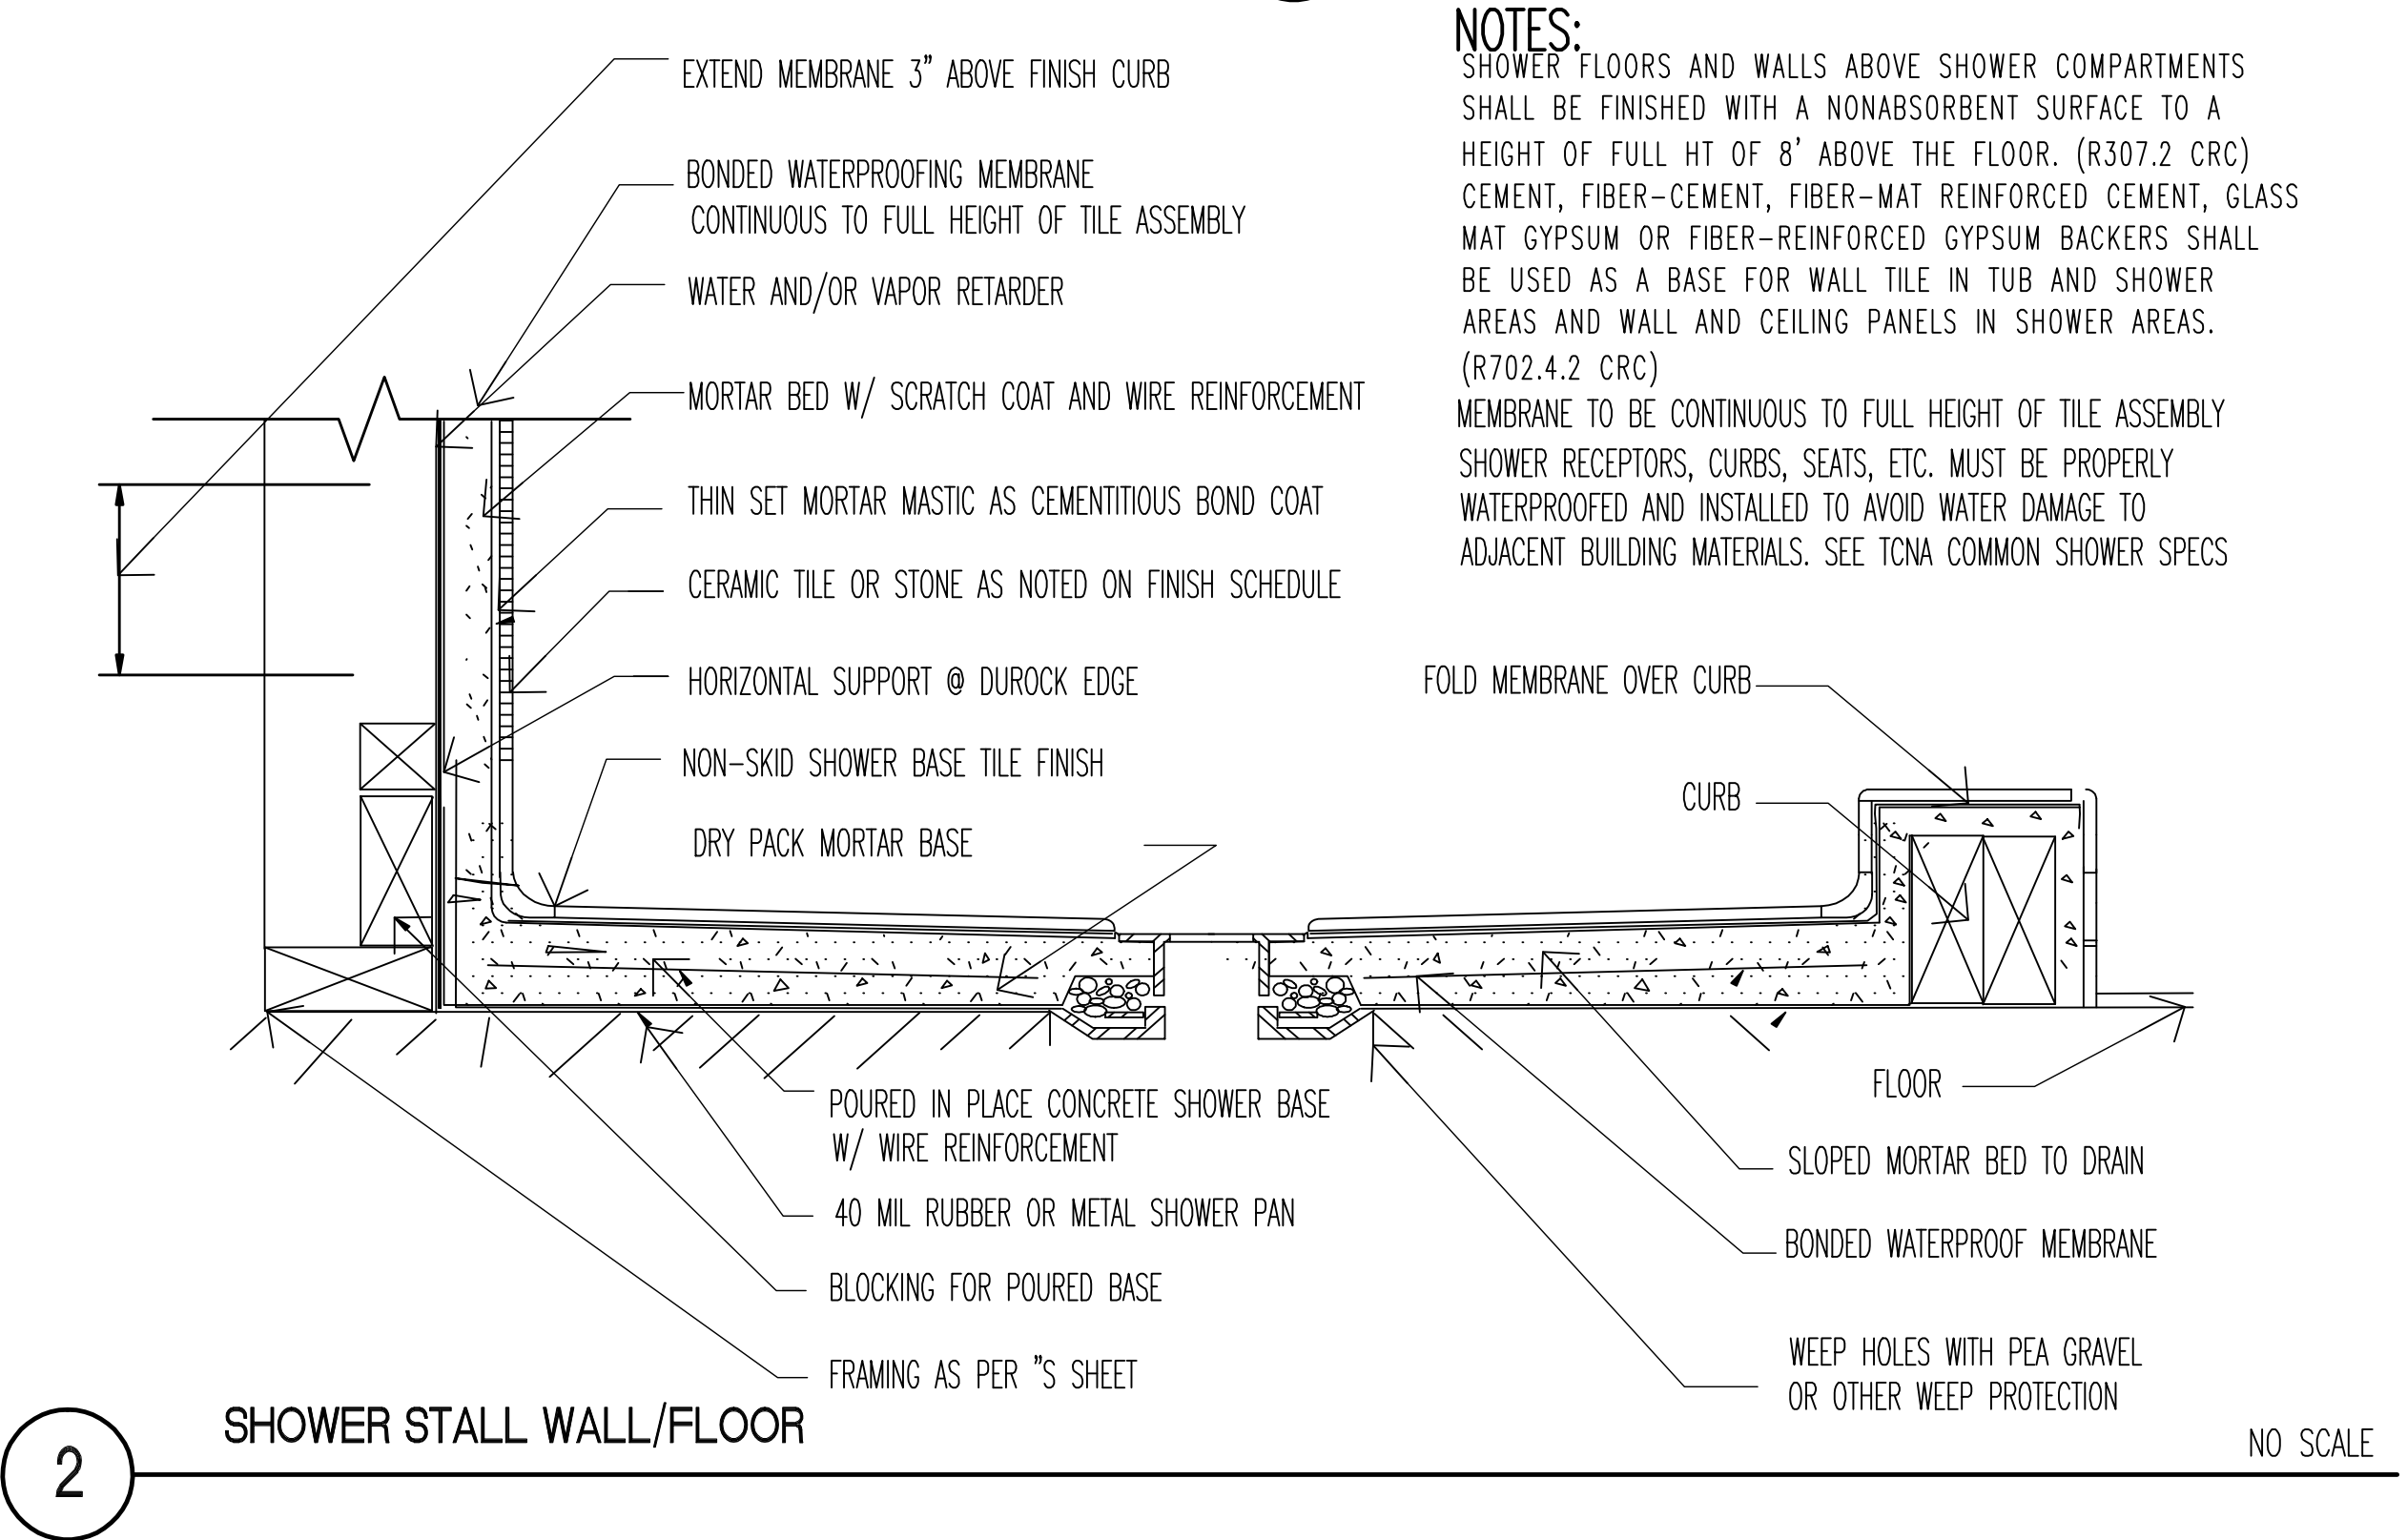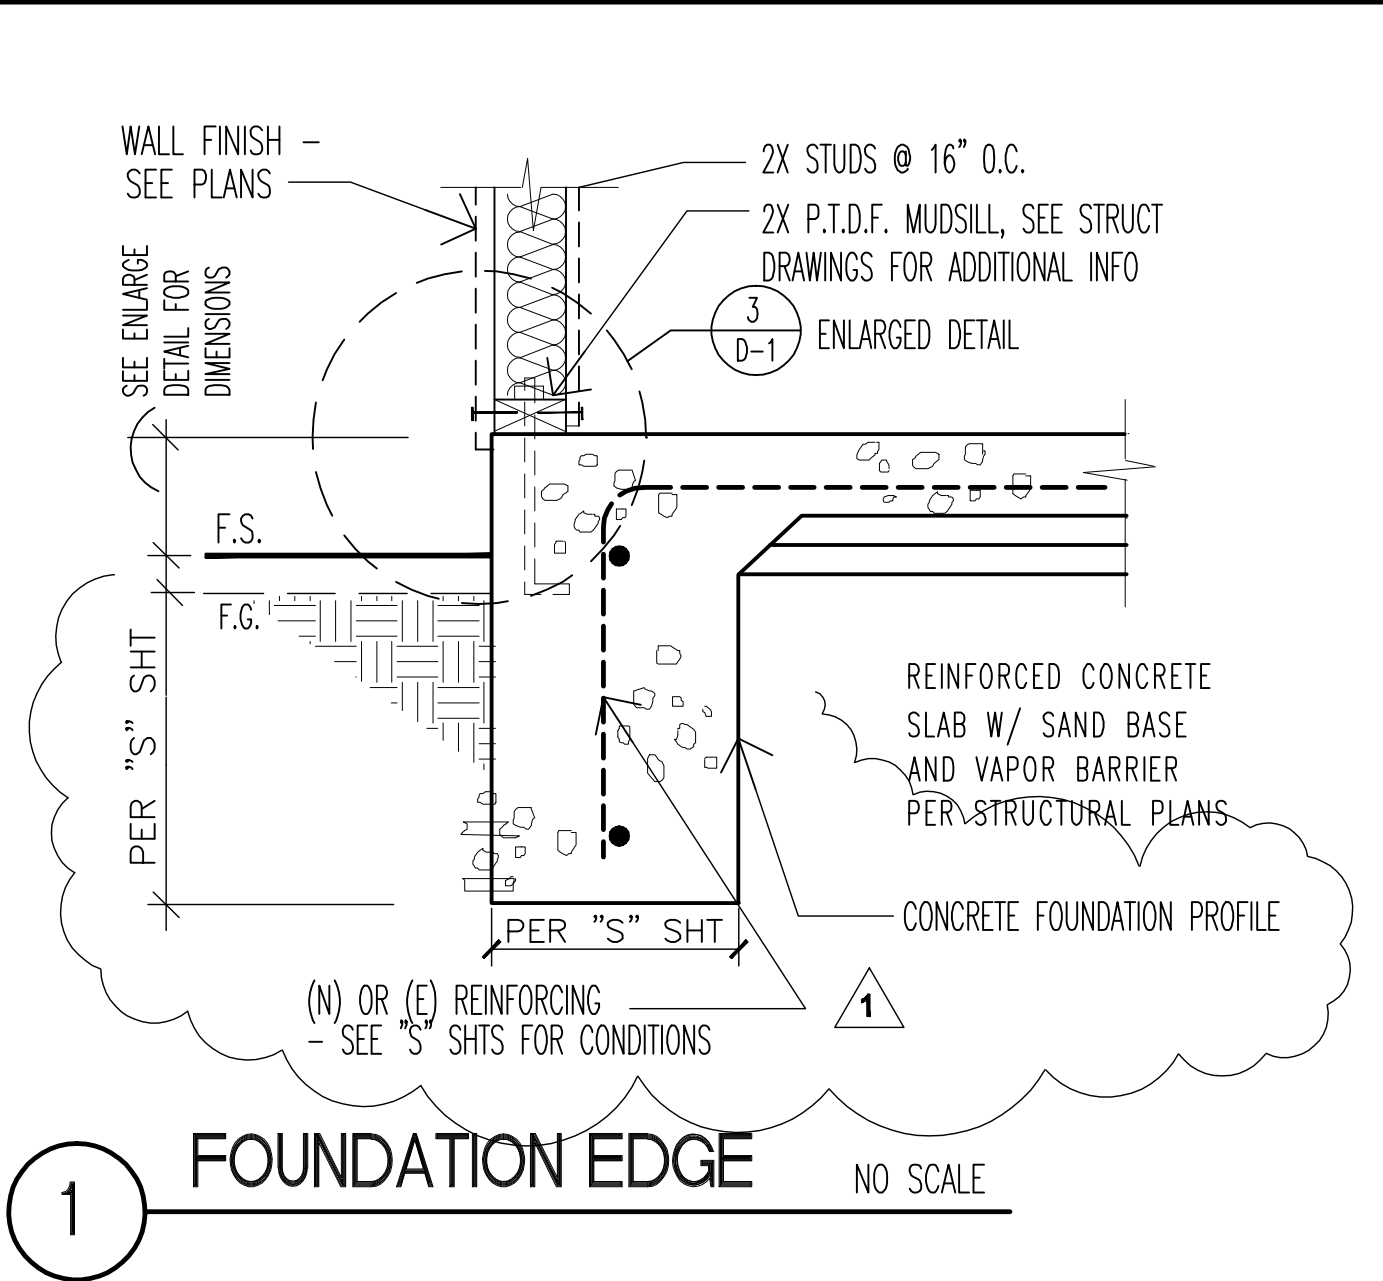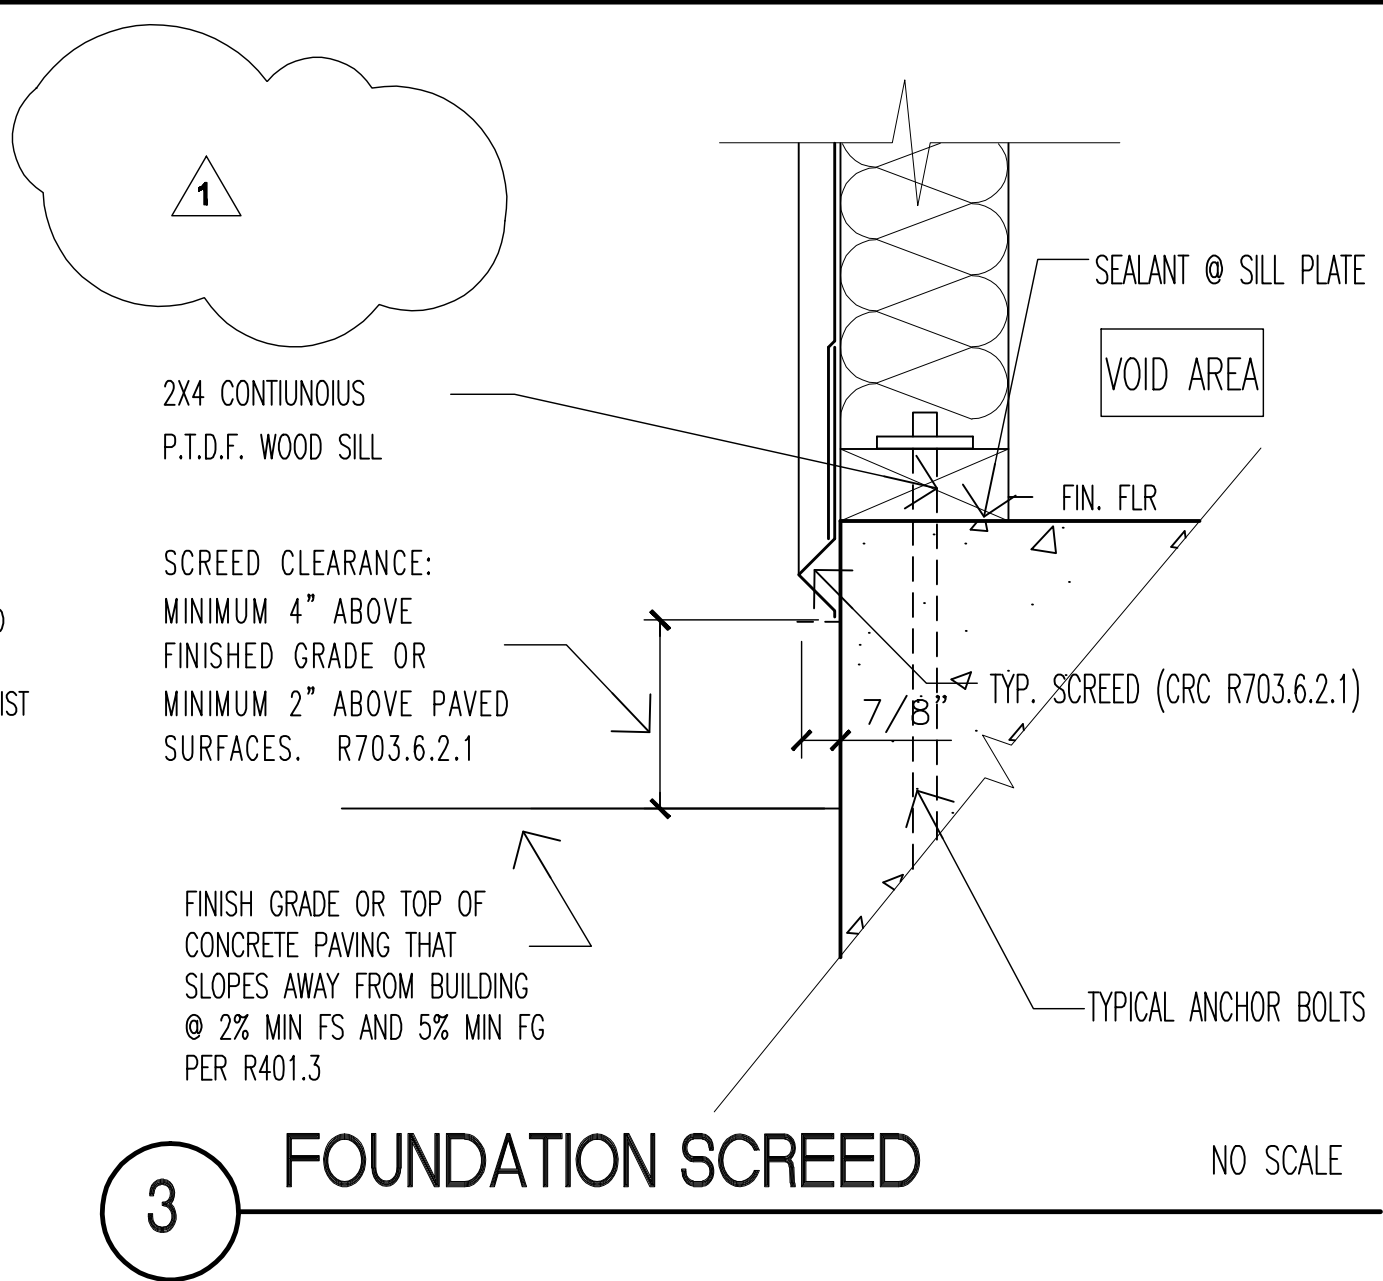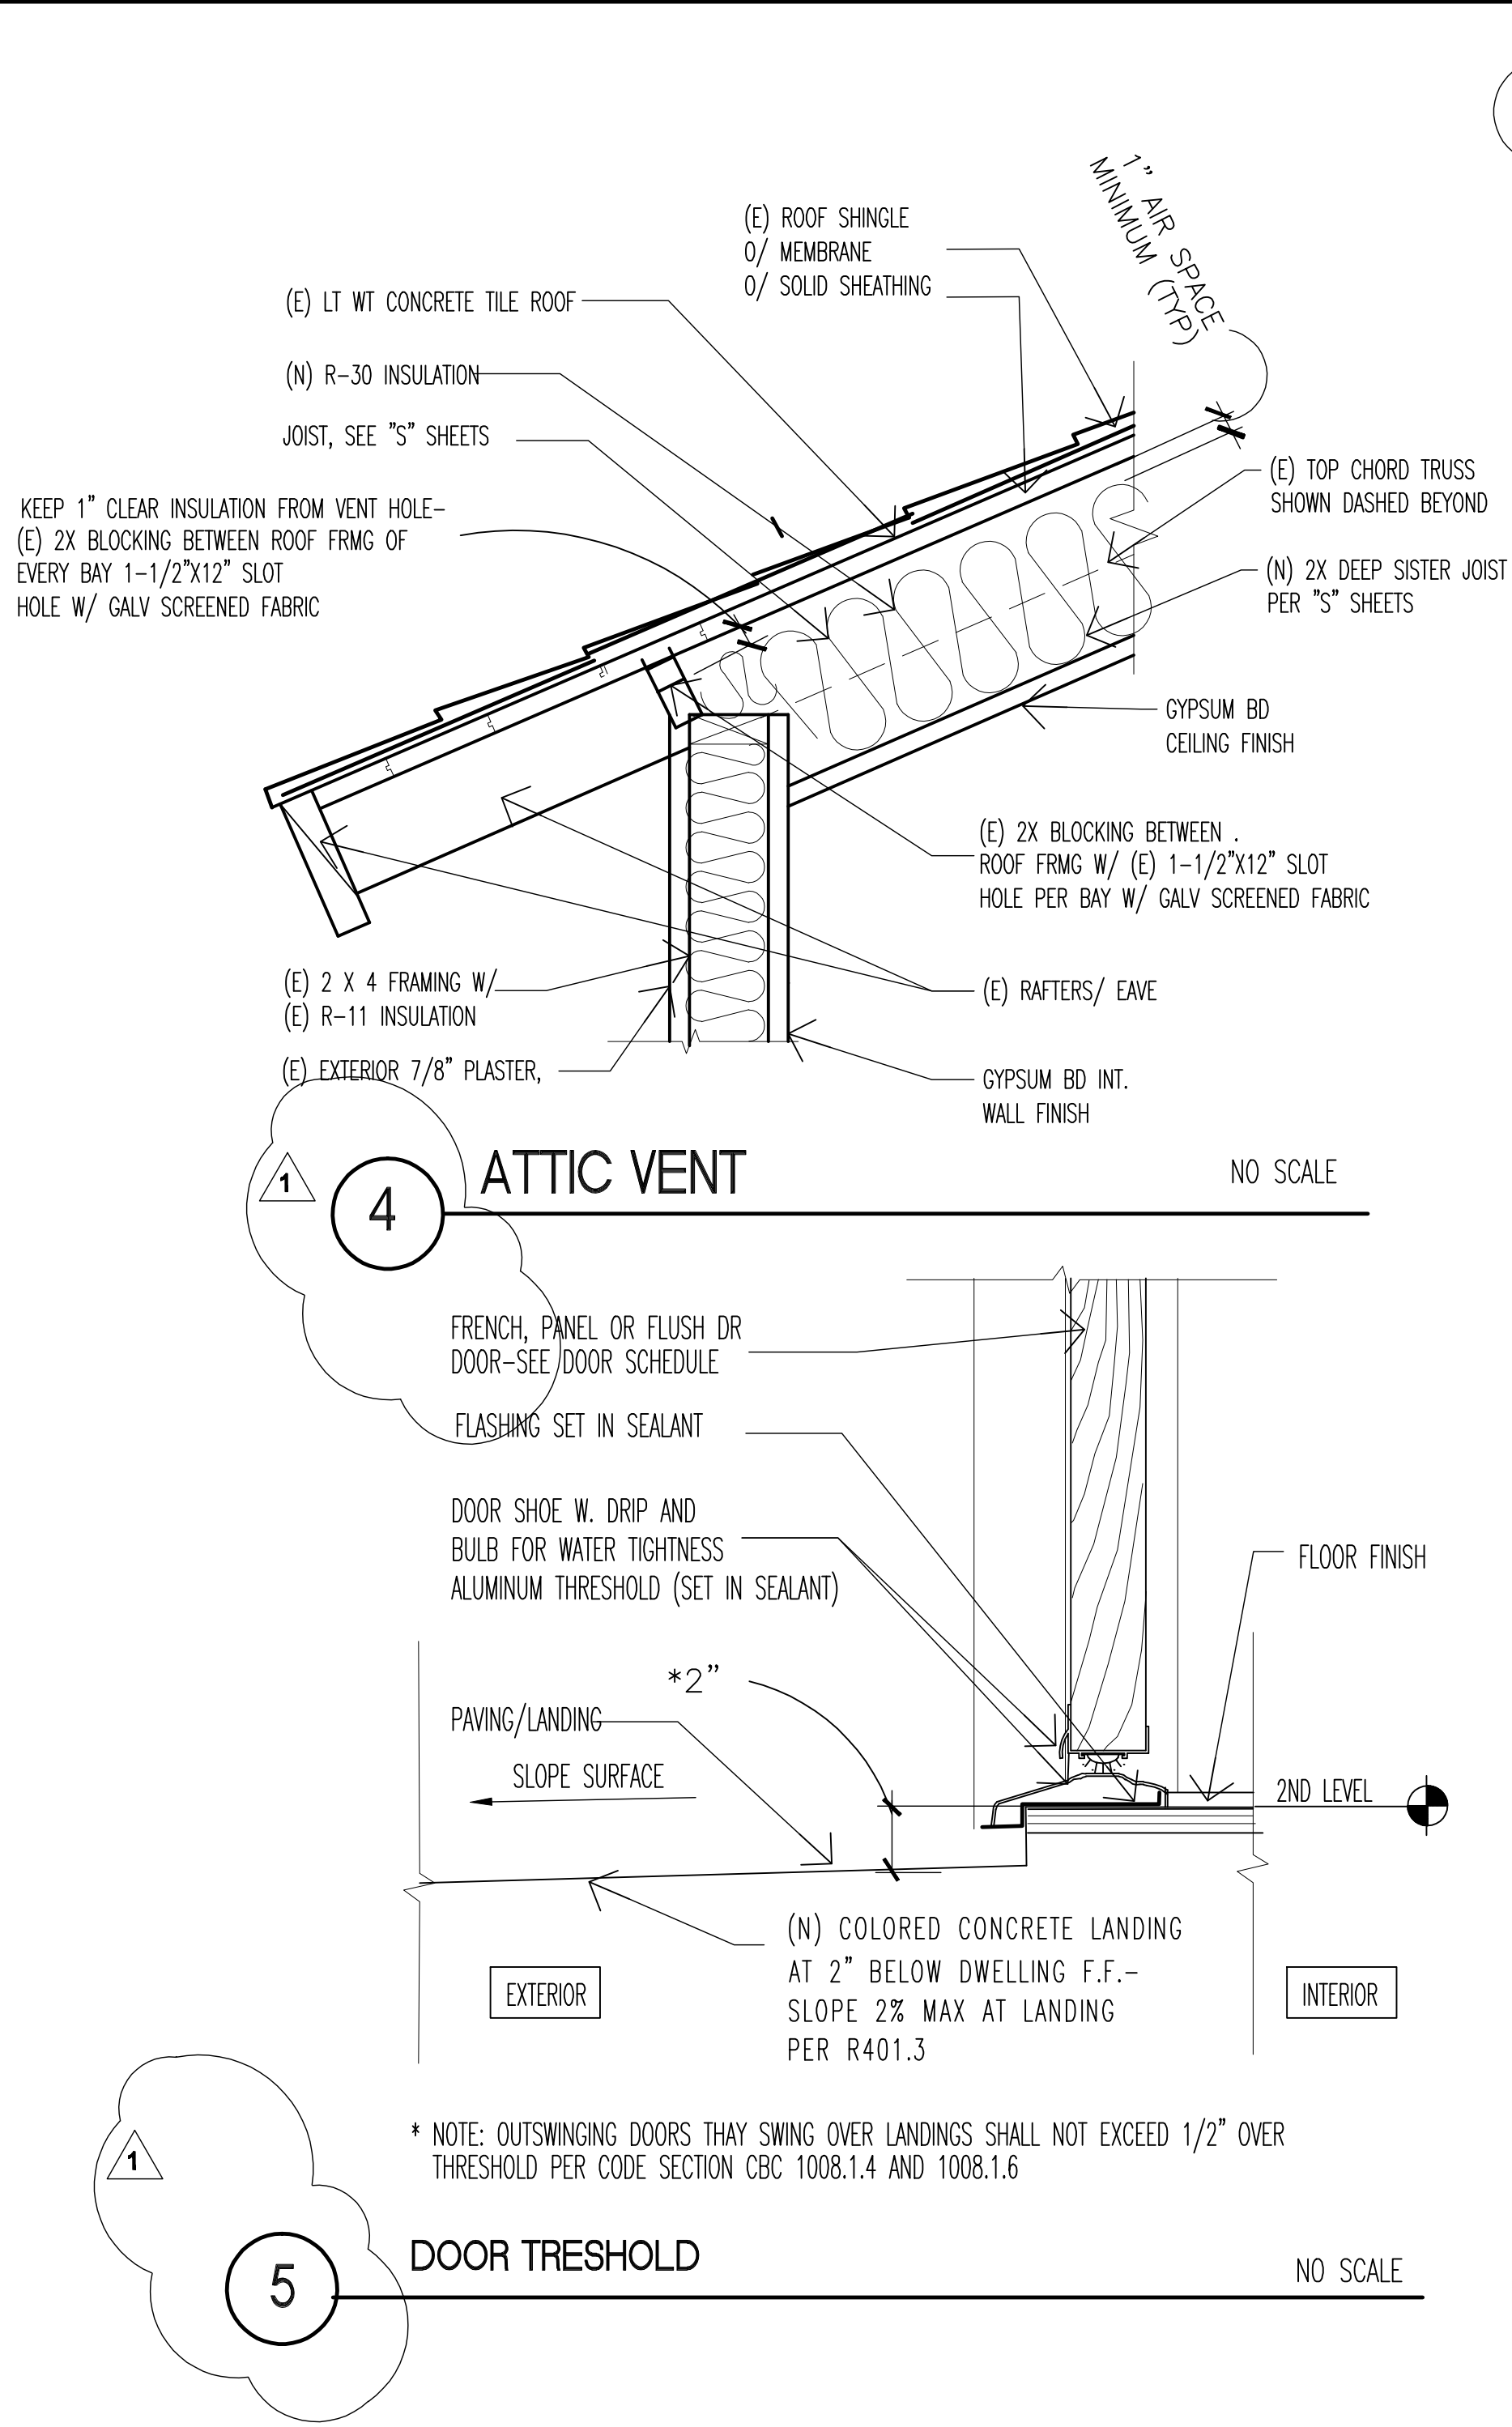

Contractor shall exercise the responsibility with architect in securing latest approved dwgs. prior to actually executing work

NO./REVISION/DATE

1 city resubmittal 4-20-20

JOHN A. SALAT ARCHITECTS
22386 Woodgrove Road, Lake Forest, CA 92630
PH 949-235-4847 email: freeingwinds@earthlink.net
zenarchitect.com

architect

GOODING RESIDENCE
SECTIONS AND DETAILS

OWNER/SITE ADDRESS:
CONTACT: Kurt Gooding
24722 Jeremiah DR.
Dana Point, CA 92629
(949) 302-1070 Email: kurt.gooding@gmail.com


REGISTERED PROFESSIONAL ARCHITECT
JOHN A. SALAT
NO. C-24445
EXP 10-29-21
STATE OF CALIFORNIA

DRAWN
5
CHECKED
5
DATE
SEE REVISION BOX ABOVE FOR DATE
SCALE
AS NOTED ON PLANS
JOB NO.
SHEET

D-1


1 OF 10 SHEETS

GAS DEMAND TOTAL BTUS = 435,000 PER TABLE 1208.4.1 & NFPA 54:5.4.2.3			
APPLIANCE:	QTY	GAS USAGE (CFH)	TOTAL GAS USAGE (CFH)
WATER HEATER	1	200	200
FIREPIT	1	40	40
DRYER	1	35	35
RANGE TOP/OVEN	1	65	65
FAU	1	65	65
BBQ UNIT	1	30	30
TOTAL GAS DEMAND			435

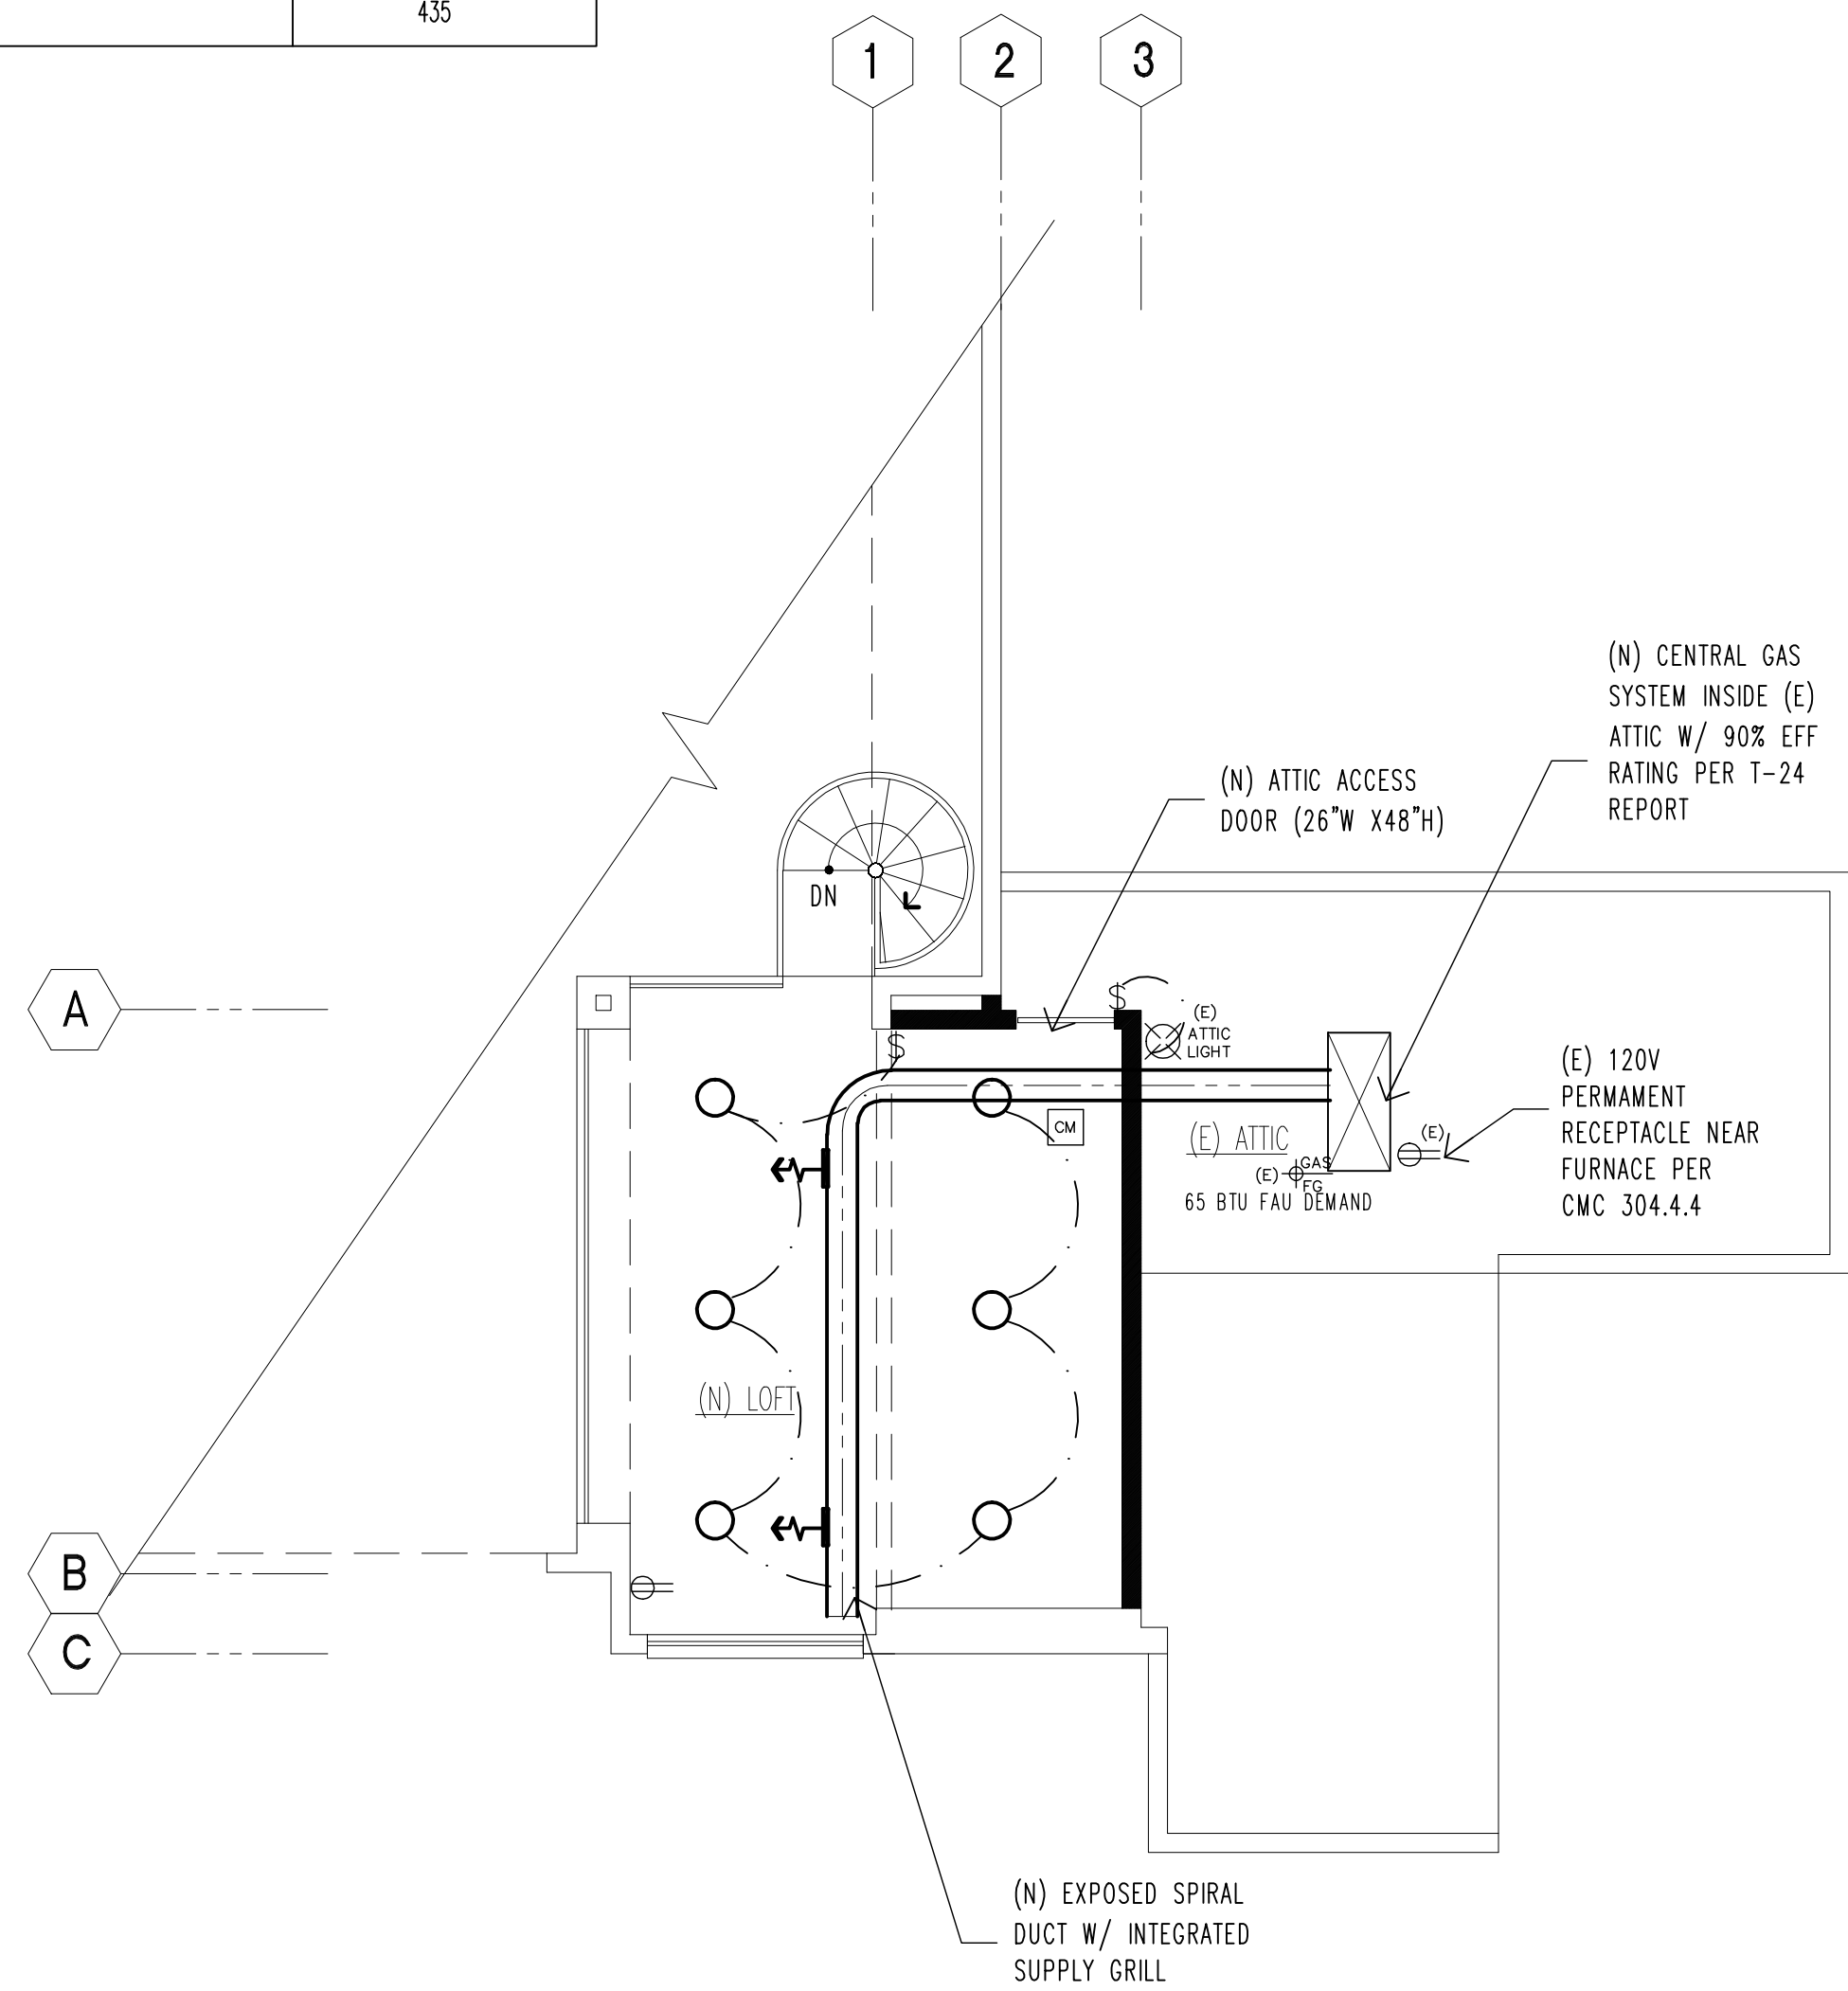


PROPOSED LOFT PLAN

SCALE: 1/4" = 1'-0"

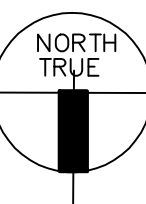

MEP NOTES

- ALL FIXTURES SHOWN ON PLAN ARE (N) OR REPLACED PRIOR TO PERMIT AS ITEMS WERE NOT VERIFIED PRIOR TO INSTALLATION AND ARE HIDDEN OR OBSCURE TO VIEW
- REFER TO MEP-2 FOR TYPICAL NOTES, SPECS AND DETAILS NOT SHOWN ON THIS SHEET
- EXHAUST DUCTS SHALL TERMINATE 3' FROM OPENINGS INTO THE BUILDING AND 10' FROM FORCED AIR INLET PER CMC 502.2.1
- PROVIDE SWITCH CONTROL LIGHTS LIGHTS AT ALL EXTERIOR DOORS PER CEC 210.70(A)
- ALL 125-VOLT, 15-AND 20 AMPERS RECEPTACLE OUTLETS SHALL BE LISTED AS "TAMPER RESISTANT RECEPTACLE" PER CEC 406.12
- WATER CLOSET TO HAVE A SIDE CLEARANCE OF 15" ON EACH SIDE MEASURED FROM THE CENTER LINE OF THE WATER CLOSET TO THE WALLS OR OTHER OBSTRUCTION

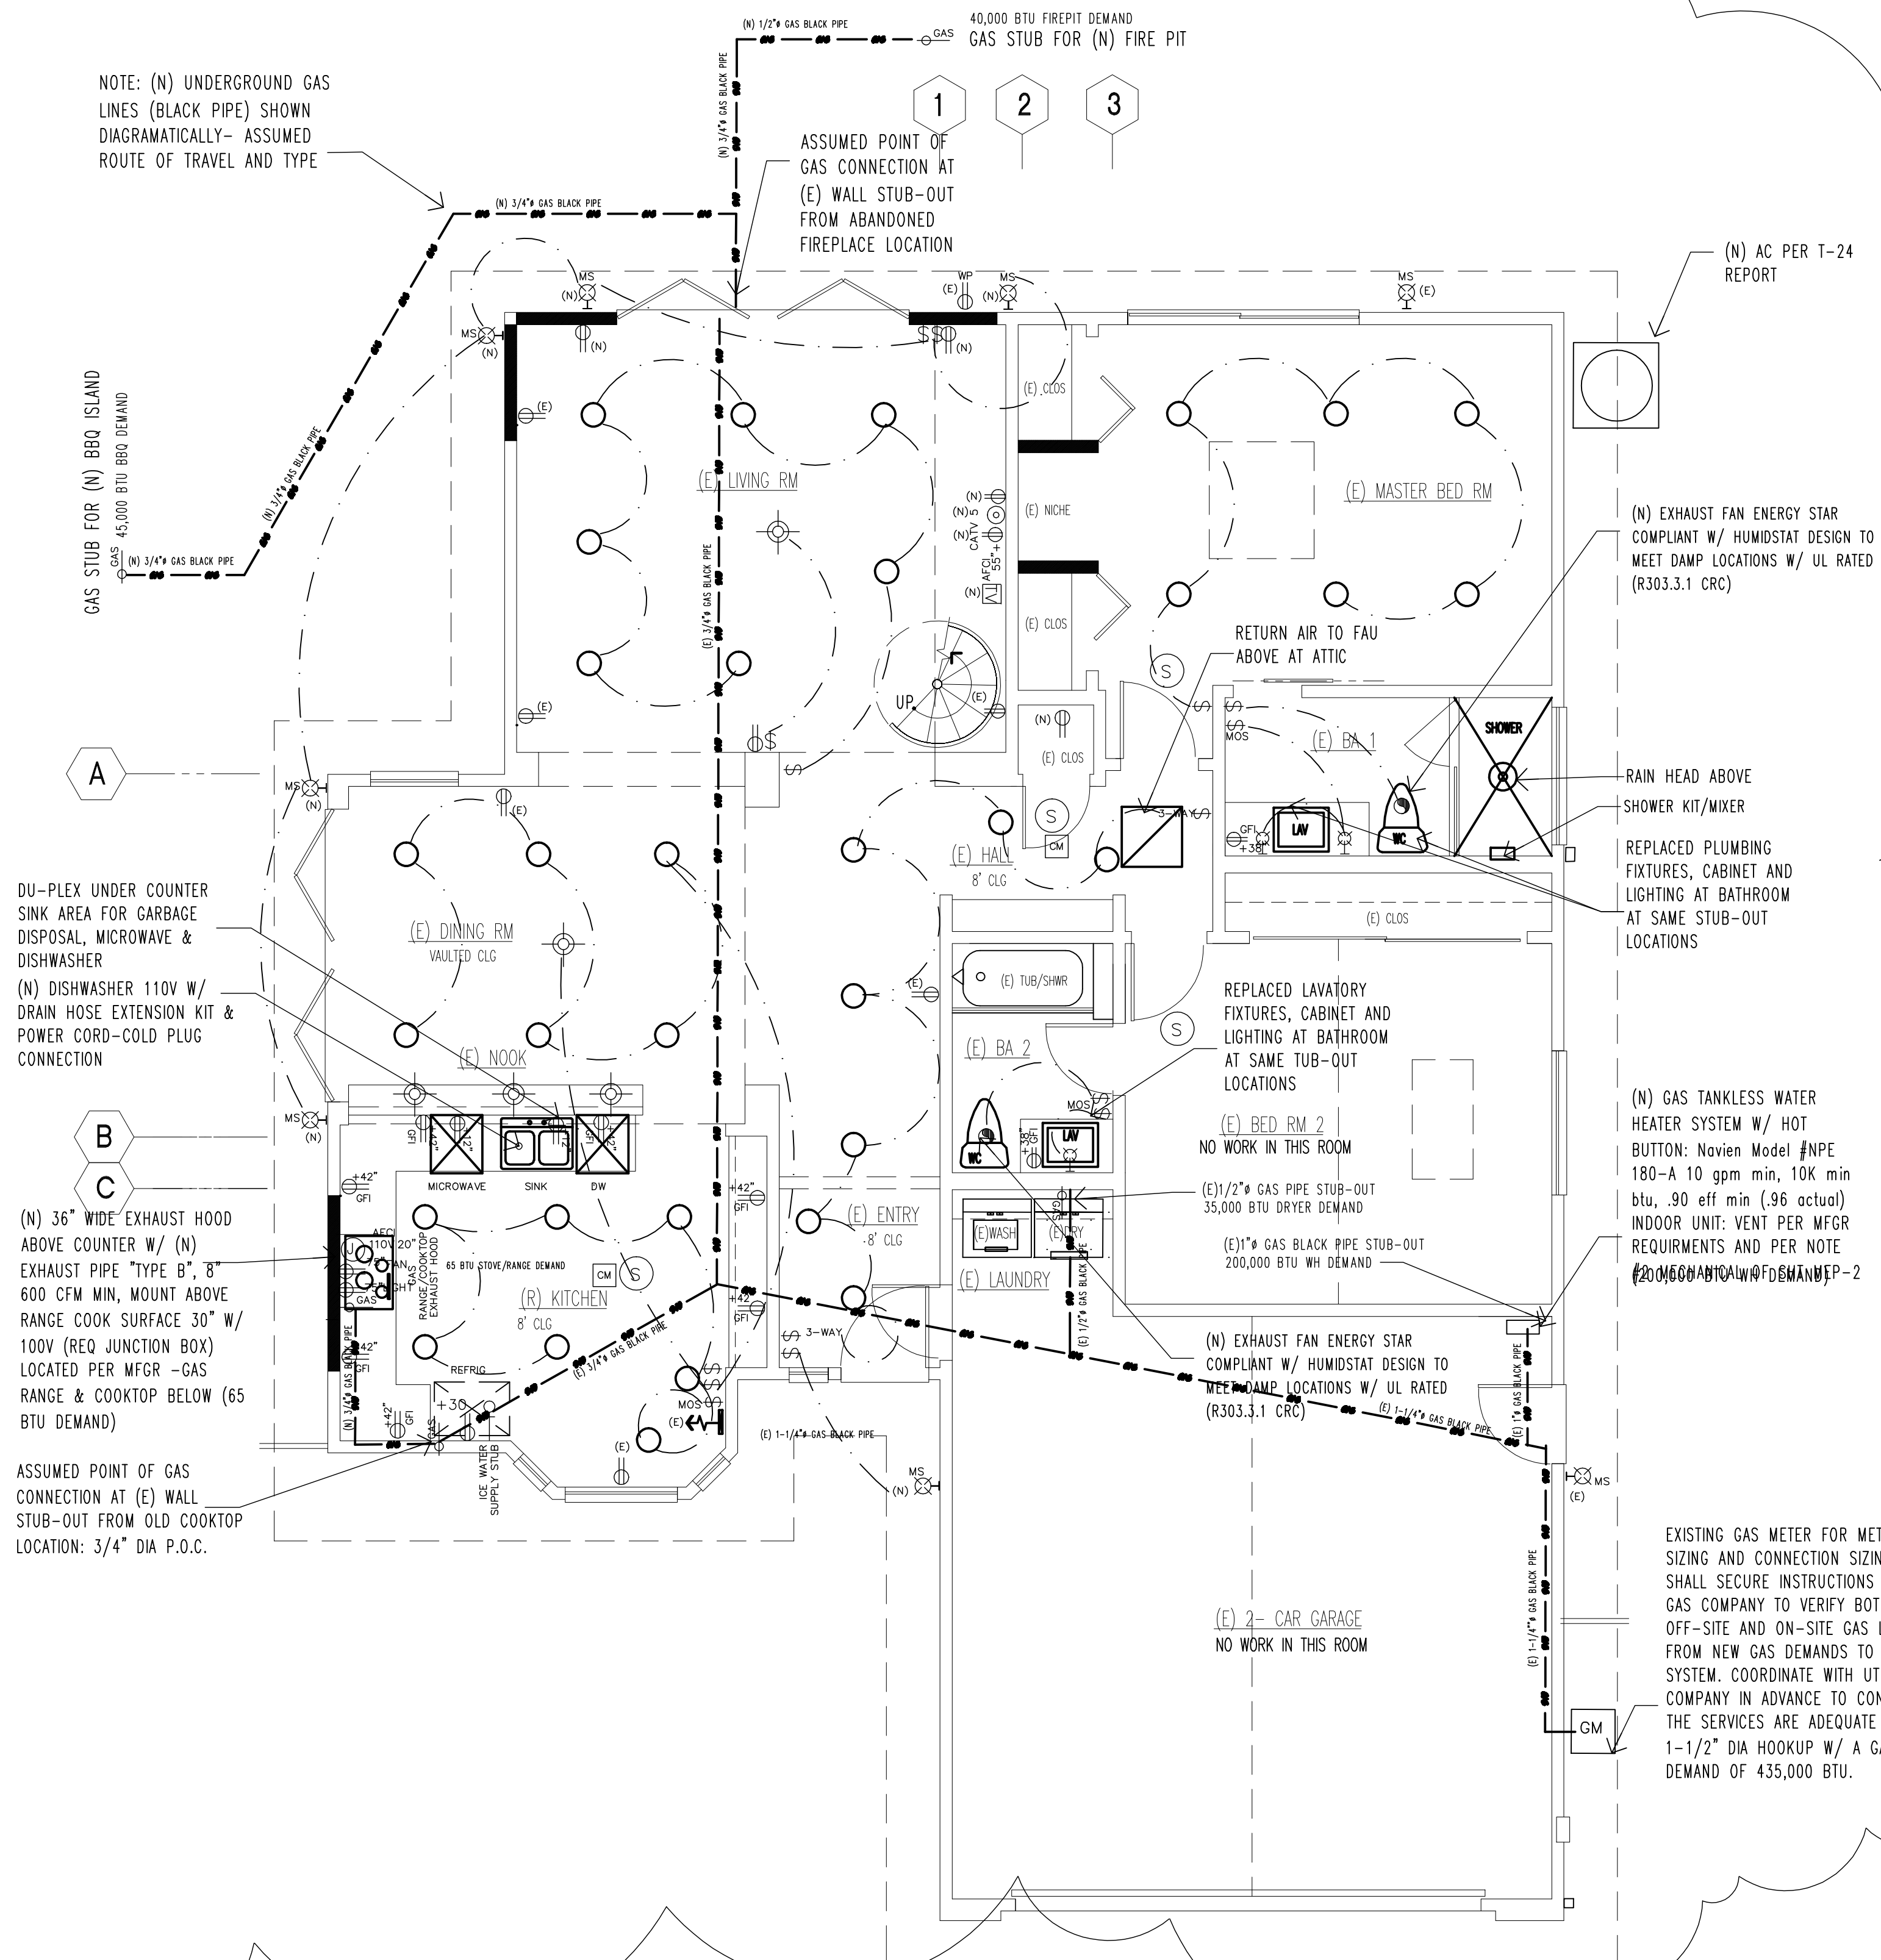

PROPOSED FLOOR PLAN

SCALE: 1/4" = 1'-0"



Contractor shall exercise the responsibility with architect in securing latest approved drawings prior to actually executing work

NO./REVISION/DATE

1 city resubmittal 4-20-20

JOHN A. SALAT ARCHITECTS
22386 Woodgrove Road, Lake Forest, CA 92630
PH 949-235-4847 email: free@johnsalat.com
zenarchitect.com

architect

GOODING RESIDENCE
ROOM ADDITION/REMODEL
MECHANICAL, ELECTRICAL
AND PLUMBING

OWNER/SITE ADDRESS:
CONTACT: Kurt Gooding
24722 Jeremiah DR.
Dana Point, CA 92629
(949) 302-1070 Email: kurt.gooding@gmail.com



DRAWN
5
CHECKED
5
DATE
SEE REVISION BOX ABOVE FOR DATE
SCALE
AS NOTED ON PLANS
JOB NO.
SHEET

MEP-1

STANDARD MEP SYMBOLS

STD MECHANICAL/ELECTRICAL/PLUMBING SPECS

electrical

TELEPHONE JACK
COMPUTER OUTLET
DOUBLE RECEPTACLE OUTLET (TAMPER-RESISTANT)
FOURPLEX OUTLET (TAMPER-RESISTANT)
GROUND FAULT INTERRUPT OUTLET PER (CEC 210.8A) (TAMPER-RESISTANT)
DUPLEX OUTLET (1/2 HOT OUTLET) TAMPER-RESISTANT
RECEPTACLE OUTLET (TAMPER-RESISTANT)
220 VOLT OUTLET
WATERPROOF GROUND FAULT INTERRUPT OUTLET OUTDOOR EXTERIOR USE PER (CEC 210-52e)
CABLE TELEVISION OUTLET
ELECTRIC METER
LIGHT SWITCH WITH DIMMER
SINGLE POLE LIGHT SWITCH
DOUBLE POLE LIGHT SWITCH 3 WAY SWITCH
4 WAY SWITCH
MOTION OCCUP. SENSOR
LED WALL MOUNTED LIGHT FIXTURE
4" SQUARE RECESSED LED CAN LIGHT FIXTURE CEILING MOUNTED
'J' BOX FOR FIXTURE IN ALLOWANCE
EXHAUST FAN (CONTROLLED BY HUMIDISTAT)
LED LIGHT & FAN COMBINATION (CONTROLLED BY HUMIDISTAT)
RECESSED MR LOW VOLTAGE DOWN LIGHT
RECESSED LOW VOLTAGE 'MR' LAMP DIRECTIONAL
ELEC. SMOKE DETECTOR w/BATT. BACKUP
LED TRACT LIGHT & LENGTH
LED STRIP LT. X 4' LENGTH SECTIONS CHAIN HUNG SHOP LAMP
WALL SCONCE LIGHTING
LED UNDER COUNTER LIGHTING STRIP WITH NON CONCEALED WIRING -COORDINATE W/ CAB'T MFGR FOR HIDING LOW VOLTAGE WIRING FROM CENTRAL TRANSFORMER NETWORK

electrical (cont)

LED PENDANT LIGHTING FIXTURE (HUNG CEILING MOUNTED ON CORD)
SURFACE CEILING MOUNT LIGHT FIXTURE
SMOKE DETECTOR- HARD WIRED W/ BATTERY BACKUP SEE NOTE 5 THIS PAGE "DIV 16- ELECT.
CARBON MONOXIDE DETECTOR HARD WIRED W/ BATTERY BACKUP PER CODE SECTION 315 -SEE NOTE 6 THIS PAGE OF "DIVISION 16- ELECT.
CATV 7 (CABLE NETWORK)
4" RECESSED LED CAN LIGHT FIXTURE CEILING MOUNTED
6" RECESSED LED CAN LIGHT FIXTURE CEILING MOUNTED
6" LED TYPE CAN HIGH EFFICACY CEILING MOUNT LIGHTS FIXTURE, (SWITCHED SEPARATELY AT KITCHEN) SEE THIS SHT DIV-16 ELECTRIC
LOW VOLTAGE LIGHT-HANG 6' FROM F.F. MINI PENDANT LAMPS
LED EXTERIOR LAMP SECURITY NIGHT LIGHT W/ MOTION CENSORED PHOTO CELL

mechanical

CEILING MOUNTED SUPPLY AIR DIFFUSER
CEILING MOUNTED RETURN AIR DIFFUSER
WALL MOUNTED SUPPLY AIR DIFFUSER
WALL MOUNTED RETURN AIR DIFFUSER
THERMOSTAT
ICE MAKER WATER SUPPLY
RECESSED ICE MAKER CONNECTION w/VALVE
RECESSED WASH MACHINE WATER & DRAIN
HOSE BIBB
HOSE BIBB w/SHUT OFF VALVE
FUEL GAS
GAS LOG LIGHTER KEY
GAS CHECK VALVE
DRYER VENT
GAS SUPPLY
WATER CLOSET

DIVISION 15 - MECHANICAL/PLUMBING

ALL GOVERNING CODES FOR THIS PROJECT ARE AS FOLLOWS:
2019 CALIFORNIA RESIDENTIAL (CRC), ELECTRICAL (CEC), MECHANICAL (CMC), CODE (EES) & PLUMBING (CPC),2019 CALIF. ENERGY EFFICIENCY STANDARDS CODES WITH LOCAL AMENDMENTS INCLUDING CALIFORNIA GREEN CODE 2019 AND 2019 ENERGY CODE (T-24)

EQUIPMENT/APPLIANCE LIST

REFER TO T-24 AND OWNERS SEPARATE LIST FOR FIXTURES

DIVISION 15 - PLUMBING

ALL EXISTING PLUMBING FIXTURES MUST BE UPGRADED PURSUANT TO CALIFORNIA CIVIL CODE, SECTIONS 1101.1 - 1101.8 TO COMPLY WITH THE FOLLOWING CONSUMPTION LIMITS:

- A. ANY TOILET MANUFACTURED TO USE MORE THAN 1.6 GALLONS OF WATER PER FLUSH.
 - B. ANY URINAL MANUFACTURED TO USE MORE THAN ONE GALLON OF WATER PER FLUSH.
 - C. ANY SHOWER HEAD MANUFACTURED TO HAVE A FLOW CAPACITY OF MORE THAN 2.5 GALLONS OF WATER PER MINUTE.
 - D. ANY INTERIOR FAUCET THAT EMITS MORE THAN 2.2 GALLONS OF WATER PER MINUTE
- NOTE TO CONTRACTOR: A COMPLETED AFFIDAVIT MAY BE PROVIDED TO THE BUILDING INSPECTOR AT OR BEFORE FINAL IN LIEU OF INSPECTIONS OF THESE FIXTURES AS NEW AND EXISTING BOTH MUST COMPLY TO CHART BELOW.

MAXIMUM FLOW RATE STANDARDS INDOOR WATER USE -G085C 4.303 RATE TO TABLE 4.303.2:

FIXTURE TYPE	FLOW RATE	CODE
SHOWER HEADS (SINGLE)	1.8 GMP @ 80 PSI	R408.2.1
MULTI-SHOWER HEAD TO OPERATE ONE HEAD AT A TIME SO THAT THE COMBINED FLOW RATE IS STILL THE SAME AS SINGLE HEAD IN SHOWER STALL AREA	1.8 GMP @ 80 PSI	R408.2.2
LAVATORY FAUCETS (RESIDENTIAL)	MAX. 1.2 GPM @ 80 PSI MIN. 0.8 GPM @ 20 PSI	R407.2.1.1
LAVATORY FAUCETS IN COMMON & PUBLIC USE AREAS	0.5 GPM @ 60 PSI	R407.1.2
KITCHEN FAUCETS	1.8 GPM @ 60 PSI	R420
METERING FAUCETS	0.2 GAL/CYCLE	R407.2.2
WATER CLOSET	1.28 GAL/FLUSH	R411

- ALL WATER INLET SUPPLY HOSE WITH TOP GRADE STAINLESS STEEL BRAIDED FLEXIBLE METAL HOSES AND ALL SHUT-OFF VALVES TO BE 1/4 TURN -NO EXCEPTIONS (TYPICAL THROUGHOUT HOUSE)
- NO GAS PIPING SHALL BE INSTALLED IN OR ON THE GROUND UNDER ANY BUILDING OR STRUCTURE. ALL EXPOSED GAS PIPING SHALL BE KEPT AT LEAST 6" ABOVE GRADE OR STRUCTURE. (CPC 1211)
- PROVIDE BONDING FROM COLD TO HOT WATER PIPING TO COMPLY WITH NEC SECTION 250-80.
- PROVIDE SOLID WASTE CONNECTORS IN LIEU OF ACCESS PANELS. (CPC 405)
- PROVIDE DEVICES TO ABSORB HIGH PRESSURES RESULTING FROM THE QUICK CLOSING OF THE QUICK-ACTING VALVES FROM THE WASHER AND DISHWASHER, ETC. (CPC)
- AT BATHTUBS AND TUB/SHOWER COMBINATIONS, CONTROL VALVES SHALL BE PRESSURE BALANCED OR MIXING. VALVES SHALL BE THERMOSTATICALLY CONTROLLED PER THE CPC SEC 410.7. 18.

DIVISION 15 - MECHANICAL

- BATHROOMS, WATER CLOSET COMPARTMENTS AND SIMILAR ROOMS SHALL BE PROVIDED WITH MECHANICAL VENTILATION PER SECTION R303.3 UNLESS WINDOWS MEET OPEN VENTILATION REQUIREMENTS.
- FUEL BURNING APPLIANCES: FUEL BURNING APPLIANCES SUCH AS WATER HEATERS AND FURNACES REQUIRE COMBUSTION AIR DUCTS AND EXHAUST VENTS THAT MUST EXTEND TO THE OUTSIDE. THOUGHT MUST BE GIVEN TO ROUTING. IT IS ADVISABLE TO LOCATE FUEL BURNING APPLIANCES ADJACENT TO AN OUTSIDE WALL FOR EASE IN PROVIDING COMBUSTION AIR. CONSULT THE 2019 CALIFORNIA MECHANICAL CODE AND 2019 CALIFORNIA ENERGY CODE. R402.4.4/N1102.4.4.
- ROOMS CONTAINING BATHTUBS, SHOWERS, SPAS AND SIMILAR BATHING FIXTURES SHALL BE MECHANICALLY VENTILATED BY EXHAUST FAN WHICH EXHAUSTS DIRECTLY -DUCTED TO TERMINATE OUTSIDE THE BUILDING CBC 1203.4.2.1 .BATHROOM FANS MUST BE ENERGY STAR COMPLIANT AND SHALL HAVE AN EXHAUST FAN THAT IS MIN. 50 CFM, A MAX SOUND RATING OR 3 SONE FOR INTERMITTENT OPERATION FOR CONTROLLED BY HUMIDITY CONTROL UNLESS EXEMPTED ELSEWHERE.
- KITCHEN EXHAUST HOOD SHALL BE A MINIMUM OF 100 CFM WITH A MAX SOUND RATING OF 3 SONE OF INTERMITTENT OPERATION. KITCHEN HOOD SHALL BE DUCTED TO OUTSIDE AIR REGARDLESS OF FUEL TYPE OR HOOD TYPE SUCH AS MICROWAVE (SUGGEST 400 CFM OR HIGHER)
- This building requires H.E.R.S verification.
All energy documentations forms must be registered H.E.R.S. provider.

HERS TESTING REQUIRED PER T-24

DIVISION 16 - ELECTRICAL

- ALL GOVERNING CODES FOR THIS PROJECT ARE AS FOLLOWS:
2019 CALIFORNIA RESIDENTIAL (CRC), ELECTRICAL (CEC), MECHANICAL (CMC), CODE (EES) & PLUMBING (CPC),2019 CALIF. ENERGY EFFICIENCY STANDARDS CODES WITH LOCAL AMENDMENTS INCLUDING CALIFORNIA GREEN CODE 2019 AND 2019 ENERGY CODE (T-24)
- ALL ELECTRICAL WORK SHALL COMPLY WITH STATE CALIFORNIA ENERGY REGULATIONS (2019 ENERGY EFFICIENCY STANDARDS)
- ALL POWER AND LIGHTING OUTLETS IN FAMILY ROOMS, PARLORS, LIBRARIES, DENS, BEDROOMS, SUNROOMS, RECREATION ROOMS, HALLWAYS & SIMILAR AREAS ARE TO BE PROTECTED BY A COMBINATION AFGI BREAKER. CEC 210.12(B). PROVIDE AT LEAST ONE RECEPTACLE OUTLET IN BATHROOM WITHIN 36 INCHES OF EACH SINK. GROUND CIRCUIT INTERRUPTER (GFI) OUTLETS SHALL BE PROVIDED IN GARAGE, ICEC 210.8(A)
PROVIDE A MINIMUM OF (1) 20-AMP CIRCUIT FOR BATHROOM(S) OUTLET. SUCH CIRCUIT SHALL HAVE NO OTHER OUTLETS. THIS CIRCUIT MAY SERVE MORE THAN ONE BATHROOM" (CEC 210-52(D)).
- NEW DWELLING, SMOKE ALARMS SHALL BE INSTALLED IN THE FOLLOWING LOCATIONS PER SECTION FOR R314 UL 217 SMOKE ALARMS:
A. IN EACH SLEEPING ROOM CONTAINING A FUEL-BURNING APPLIANCE.
B. OUTSIDE EACH SEPARATE SLEEPING AREA IN THE VICINITY OF THE BEDROOMS.
C. IN EACH STORY, INCLUDING BASEMENTS AND HABITABLE ATTICS.
D. AND IN DWELLING UNITS THAT HAVE AN ATTACHED GARAGE. ICRC R315
E. WHEN ONE OR MORE SMOKE ALARM IS REQUIRED THE ALARM DEVICE SHALL BE INTERCONNECTED IN SUCH MANNER THAT THE ACTUATION OF ONE ALARM WILL ACTIVATE ALL OF THE ALARMS IN THE INDIVIDUAL UNIT.
- AN APPROVED CARBON MONOXIDE ALARM SHALL BE INSTALLED IN DWELLING UNITS AND IN SLEEPING UNITS WITHIN WHICH FUEL-BURNING APPLIANCES ARE INSTALLED AND IN DWELING UNITS THAT HAVE ATTACHED GARAGES IN ACCORDANCE WITH R31 UL 2034/2075. CARBON MONOXIDE ALARMS SHALL ONLY BE REQUIRED IN SPECIFIC DWELLING UNITS OR SLEEPING UNITS FOR WHICH THE PERMIT WAS OBTAINED. THE ALARMS SHALL BE INSTALLED IN THE FOLLOWING LOCATIONS: A. OUTSIDE EACH SEPARATE DWELLING UNIT SLEEPING AREA IN THE IMMEDIATE VICINITY OF THE BEDROOM(S). B. ON EVERY LEVEL OF A DWELLING UNIT INCLUDING BASEMENTS. C WHERE MORE THAN ONE ALARM IS REQUIRED TO BE INSTALLED WITHIN THE DWELLING UNIT OR WITHIN A SLEEPING UNIT THE ALARM SHALL BE INTERCONNECTED IN A MANNER THAT ACTIVATION OF ONE ALARM SHALL ACTIVATE ALL THE ALARMS IN THE INDIVIDUAL UNIT.
- EXCEPTION SMOKE AND CARBON MONOXIDE ALARMS:
INTERCONNECTION IS NOT REQUIRED IN EXISTING DWELLING UNITS WHERE REPAIRS DO NOT RESULT IN THE REMOVAL OF WALL AND CEILING FINISHES, THERE IS NO ACCESS BY MEANS OF ATTIC, BASEMENT OR CRAWL SPACE, AND NO PREVIOUS METHOD FOR INTERCONNECTION EXISTED.
- RECESSED LUMINARIES INSTALLED IN INSULATED CEILING SHALL BE IC RATED (ZERO CLEARANCE) AND AT RATED (AIR TIGHT) AND SHALL BE SEALED AND/OR GASKETED BETWEEN CEILING AND HOUSING. IN COMPLIANCE WITH SECTION 150 (K)4. INTERIOR LIGHTING SWITCHING DEVICES AND CONTROLS:
A. All forward phase cut dimmers used with LED light sources shall comply with NEMA SSL 7A.
B. Exhaust fans shall be controlled separately from lighting systems. SECTION 150.0 - MANDATORY FEATURES AND DEVICES
EXCEPTION to Section 150.0(k)2B: Lighting integral to an exhaust fan may be on the same control as the fan provided the lighting can be turned OFF in accordance with the applicable provisions in Section 150.0(k)2 while allowing the fan to continue to operate.
C. Lighting shall have readily accessible wall-mounted controls that allow the lighting to be manually turned ON and OFF.
EXCEPTION to Section 150.0(k)2C: Ceiling fans may provide control of integrated lighting via a remote control.
D. Lighting controls and equipment shall be installed in accordance with the manufacturer's instructions.
E. No controls shall bypass a dimmer, occupant sensor or vacancy sensor function where that dimmer or sensor has been installed to comply with Section 150.0(k).
F. Lighting controls shall comply with the applicable requirements of Section 110.9.
G. An Energy Management Control System (EMCS) may be used to comply with control requirements in Section 150.0(k) if at a minimum it provides the functionality of the specified controls in accordance with Section 110.9, meets the installation certificate requirements in Section 130.4, meets the EMCS requirements in Section 130.0(e), and complies with all other applicable requirements in Section 150.0(k)2.
H. A Multiscene programmable controller may be used to comply with dimmer requirements in Section 150.0(k) if at a minimum it provides the functionality of a dimmer in accordance with Section 110.9, and complies with all other applicable requirements in Section 150.0(k)2.
I. In bathrooms, garages, laundry rooms, and utility rooms, at least one luminaire in each of these spaces shall be controlled by an occupant or vacancy sensor providing automatic-off functionality. If an occupant sensor is installed, it shall be initially configured to manual-on operation using the manual control required under Section 150.0(k)2C.
J. Luminaires that are or contain light sources that meet Reference Joint Appendix JA8 requirements for dimming, and that are not controlled by occupancy or vacancy sensors, shall have dimming controls.
EXCEPTION 1 to Section 150.0(k)2J: Luminaires in closets less than 70 square ft

9. omit
10. omit

- ANY FIXED APPLIANCE SUCH AS DISPOSAL, DISHWASHER, CLOTHES WASHER, DRYER, BUILT-IN HEATERS, OR ANY OTHER FIXED APPLIANCE WITH 1/4 H.P. MOTOR OR LARGER, SHALL BE ON A SEPARATE #12 AWG WIRE BRANCH CIRCUIT. EACH DWELLING UNIT SHALL HAVE INSTALLED THEREIN AN INDIVIDUAL DISPOSAL CIRCUIT SUPPLIED WITH MINIMUM #12 AWG WIRE AND A 15 AMP INDICATING-TYPE SWITCH. [CEC 210.23 &220]
- LUMINARIES PROVIDING RESIDENTIAL OUTDOOR LIGHTING SHALL MEET THE FOLLOWING REQUIREMENTS AS APPLICABLE:
OUTDOOR LIGHTING PERMANENTLY MOUNTED TO A RESIDENTIAL BUILDING OR, TO OTHER BUILDINGS ON THE SAME LOT SHALL MEET THE REQUIREMENT IN ITEM #a) AND THE REQUIREMENTS INTEN #a) SHALL MEET THAT EITHER ITEM TO #b) OR #c) AS FOLLOWS:
a). CONTROLLED BY MANUAL ON AND OFF SWITCH THAT DOES NOT GO OVERRIDE TO ON THE AUTOMATIC ACTIONS OF THE ITEM #2 OR #3; AND
b). CONTROLLED BY PHOTOCELL AND MOTION SENSOR CONTROLS THAT OVERRIDE TO ON SHALL NOT BE ALLOWED UNLESS THE OVERRIDE AUTOMATICALLY REACTIVATES THE MOTION SENSOR WITHIN 6 HOURS OR,
c). CONTROL BY ONE OF THE FOLLOWING METHODS:
aa) PHOTOCONTROL AND AUTOMATIC TIME SWITCH CONTROL. CONTROLS THAT OVERRIDE TO ON SHALL NOT BE ALLOWED UNLESS THE OVERRIDE SHALL AUTOMATICALLY RETURN THE PHOTOCONTROL AND AUTOMATICALLY TIME SWITCH CONTROL TO ITS NORMAL OPERATION WITHIN 6 HOURS. OR
bb) ASTRONOMICAL TIME CLOCK, CONTROLS THAT OVERRIDES TO ON SHALL NOT BE ALLOWED UNLESS YOU OVERRIDE SHALL AUTOMATICALLY RETURN THE ASTRONOMICAL CLOCK TO ITS NORMAL OPERATION WITHIN 6 HOURS AND WHICH IS PROGRAM TO AUTOMATICALLY TURN THE OUTDOOR SWITCH OFF DURING DAYLIGHT HOURS.

abbreviations


MSIPC= MOTION SENSOR W/ INTEGRATED PHOTO CELL UNIT-SEE THIS SHEET DIV-16 ELECTRIC

MOS= MOTION OCCUPANCE SENSOR

AFCI = ARC FAULT CIRCUIT INTERRUPTER SEE THIS SHEET DIV-16 ELECTRIC

(E) = EXISTING
(N) = NEW

WL = WET LOCATION RECESSED LIGHT FIXTURE PER NEC 410

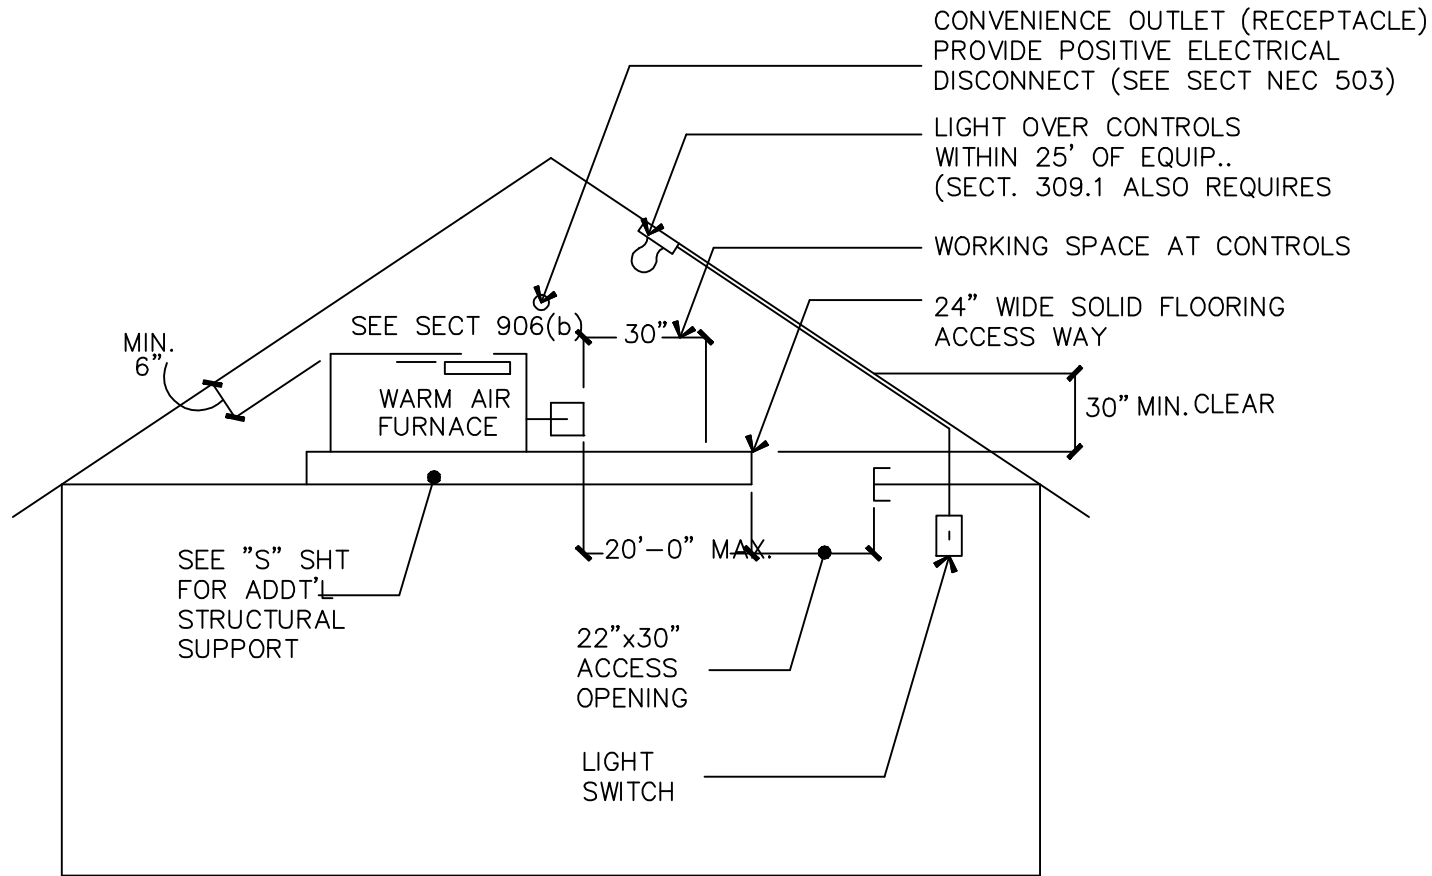

RELATED CODES SECTIONS: 309.1, 319 CMC 904.2
CENTRAL WARM-AIR FURNACES INSTALLED IN ATTICS MUST BE ACCESSIBLE FOR ROUTINE INSPECTION AND MAINTENANCE BY THE OWNER/OCCUPANT AND FOR SERVICE AND REPAIR AS NEEDED. CHANGING FILTERS, LUBRICATING MOTOR AND FAN BEARINGS, CHECKING BELT TENSIONS AND RELIGHTING THE PILOT FOLLOWING A SERVICE INTERRUPTION ARE NORMAL OWNER FUNCTIONS. ADEQUATE LIGHT, AN ELECTRICAL OUTLET, SAFE ACCESS WAY AND SUFFICIENT WORKING SPACE ON THE CONTROL SIDE ALL ENCOURAGE AND FACILITATE MAINTENANCE AND ALSO ENABLE RAPID EGRESS IN AN EMERGENCY.

STD EQUIPMENT ATTIC SECTION LAYOUT

1

Contractor shall exercise the responsibility with architect securing latest approved drawings prior to actually executing work


NO./REVISION/DATE
1 city resubmittal 4-20-20

JOHN A. SALAT ARCHITECTS
22386 Woodgrove Road, Lake Forest, CA 92630
PH 949-235-4847 email: treaingwinds@earthlink.net
zenarchitect.com

architect

GOODING RESIDENCE
ROOM ADDITION/REMODEL
MECHANICAL- ELECTRICAL
AND PLUMBING

OWNER/SITE ADDRESS:
CONTACT: Kurt Gooding
24722 Jeremiah DR.
Dana Point, CA 92629
(949) 302-1070 Email: kurt.gooding@gmail.com

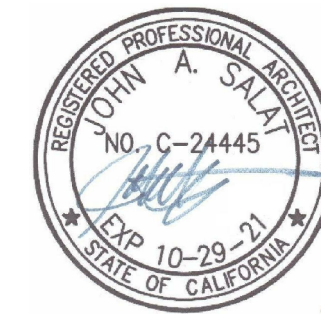

DRAWN

CHECKED

DATE

SEE REVISION BOX ABOVE FOR DATE

SCALE

AS NOTED ON PLANS

JOB NO.

SHEET

MEP-2

CALGREEN - RESIDENTIAL
MINIMUM REQUIREMENTS

Scope

1. 2019 California Green Building Standards Code (CG) is applicable to all new residential buildings, including but not limited to, dwellings, apartment houses, condominiums, hotels, and other types of dwellings containing sleeping accommodations with or without common toilets or cooking facilities regulated by the Department of Housing and Community Development (HCD-1). (NBMC 15.11.010, CG Section 101.3.1).
2. 2019 California Green Building Standards Code (CG) is applicable to additions or alterations of existing residential buildings where the addition or alteration increases the building's conditioned area, volume, or size. The requirements shall apply only to and/or within the specific area of the addition or alteration. (301.1.1)

Energy Efficiency

3. New one and two family dwellings and townhouses with attached private garages shall install a listed nominal 1 inch inside diameter raceway to accommodate a dedicated 208/240 volt branch circuit. (4.106.4.1)
- a. The raceway shall originate at the main service or subpanel and terminate into a listed cabinet, box, or enclosure in close proximity to the proposed location of an EV charger.
- b. The service panel or subpanel shall provide capacity to install a minimum 40 ampere dedicated branch circuit and space reserved for installation of a branch circuit overcurrent protective device.
- c. The service panel or subpanel circuit directory shall identify the overcurrent protective devices space reserved for future EV charging as "EV CAPABLE."
- d. The raceway termination location shall be permanently and visibly marked as "EV CAPABLE."

Material Conservation and Resources Efficiency

4. Annular spaces around pipes, electric cables, conduits or other openings in sole/bottom plates at exterior walls shall be protected against the passage of rodents by closing such openings with cement mortar, concrete masonry or other similar method. (4.406.1)
5. Utilize one of the city's approved franchise hauler to recycle and/or salvage a minimum of 65% of the nonhazardous construction and demolition waste. (4.408.1, 4.408.3)

Water Efficiency and Conservation

6. New residential developments with an aggregate landscape area equal to or greater than 500 square feet shall comply with City's water efficient landscape ordinance. (4.304.1, NBMC 14.17)
7. Plumbing fixtures and fittings shall comply with the following (4.303.1):

FIXTURE TYPE	MAXIMUM FLOW RATE
Single Showerheads	1.8 gpm @ 80 psi
Multiple Showerheads	Combine flow rate of 2.0 gpm @80 psi
Residential Lavatory Faucets	1.2 gpm @ 60 psi ² maximum
Common and Public use Lavatory Faucets	0.5 gpm @60 psi
Kitchen Faucets	1.8 gpm @ 60 psi
Metering Faucets	0.25 gallons per cycle maximum
Water Closets	1.28 gallons/flush
Wall Mounted Urinal	0.128 gallons/flush
All Other Types of Urinal	0.5 gallons/flush

1. Includes single and dual flush water closets with an effective flush rate of 1.28 gallons or less when tested per ASME A122.19.233.2 for single flush and ASME A112.19.14 for dual flush toilets.
2. Lavatory faucets shall not have a flow rate less than 0.8 gpm at 20 psi.

Environmental Quality

8. Moisture content of building materials used in wall and floor framing is checked before enclosure according to one of the following (4.505.3):
- a. Moisture content shall be determined with either a probe-type or contact-type moisture meter. Equivalent moisture verification methods may be approved by the enforcing agency and shall satisfy requirements found in Section 101.8 of this code.
- b. Moisture readings shall be taken at a point 2 feet (610 mm) to 4 feet (1219 mm) from the grade stamped end of each piece to be verified.
- c. At least three random moisture readings shall be performed on wall and floor framing with documentation acceptable to the enforcing agency provided at the time of approval to enclose the wall and floor framing.
9. Aerosol paints and coatings shall meet the Product-weighted MIR Limits for ROC in Section 94522(a)(2) and other toxic requirements in Sections 94522(e)(1) and (f)(1) of the California Code of Regulations, Title 17, commencing with Section 94520. (4.504.2.3)
10. Carpet and carpet systems shall be compliant with of the following (4.504.3):
- a. Carpet and Rug Institute's Green Label Plus Program.
- b. California Department of Public Health Specification 01350.
- c. NSF/ANSI 140 at the Gold level.
- d. Scientific Certifications Systems Indoor Advantage™ Gold
11. Minimum 80% of floor area receiving resilient flooring shall comply with one of the following (4.504.4):
- a. VOC emission limits defined in the Collaborative for High Performance Schools (CHPS) High Performance Product Database.
- b. Products certified under UL GREENGUARD Gold.
- c. Certified under the Resilient Floor Covering Institute (RFCI) FloorScore program.
- d. California Department of Public Health Specification 01350.

12. Adhesives, sealants and caulks shall be compliant with volatile organic compound (VOC) limits set forth in Table 4.504.1 or Table 4.504.2. (4.504.2.1)

ADHESIVE VOC LIMIT ^{1,2} (Less Water and Less Exempt Compounds in Grams per Liter)	
ARCHITECTURAL APPLICATIONS	VOC LIMIT
Indoor carpet adhesives	50
Carpet pad adhesives	50
Outdoor carpet adhesives	150
Wood flooring adhesive	100
Rubber floor adhesives	60
Subfloor adhesives	50
Ceramic tile adhesives	65
VCT and asphalt tile adhesives	50
Drywall and panel adhesives	50
Cove base adhesives	50
Multipurpose construction adhesives	70
Structural glazing adhesives	100
Single-ply roof membrane adhesives	250
Other adhesives not specifically listed	50
SPECIALTY APPLICATIONS	
PVC welding	510
CPVC welding	490
ABS welding	325
Plastic cement welding	250
Adhesive primer for plastic	550
Contact adhesive	80
Special purpose contact adhesive	250
Structural wood member adhesive	140
Top and trim adhesive	250
SUBSTRATE SPECIFIC APPLICATIONS	
Metal to metal	30
Plastic foams	50
Porous material (except wood)	50
Wood	30
Fiberglass	80

1. If an adhesive is used to bond dissimilar substrates together, the adhesive with the highest VOC content shall be allowed.
2. For additional information regarding methods to measure VOC content specified in table, see South Coast Air Quality Management District Rule 1108.

SEALANT VOC LIMIT (Less Water and Less Exempt Compounds in Grams per Liter)	
SEALANTS	VOC LIMIT
Architectural	250
Marine deck	760
Nonmembrane roof	300
Roadway	250
Single-ply roof membrane	450
Other	420
SEALANT PRIMERS	
Architectural	
Nonporous	250
Porous	775
Modified bituminous	500
Marine deck	760
Other	750

13. Paints, stains, and other coatings shall be compliant with VOC and other toxic compound limits set forth in Table 4.504.3. (4.504.2.2)

VOC CONTENT LIMITS FOR ARCHITECTURAL COATINGS ^{2,3} (Grams of VOC per Liter of Coating, Less Water and Less Exempt Compounds)	
COATING CATEGORY	VOC LIMIT
Flat coatings	50
Nonflat coatings	100
Nonflat-high gloss coatings	150
Specialty Coatings	
Aluminum roof coatings	400
Basement specialty coatings	400
Bituminous roof coatings	50
Bituminous roof primers	350
Bond breakers	350
Concrete curing compounds	350
Concrete/masonry sealers	100
Driveway sealers	50
Dry fog coatings	150
Faux finishing coatings	350
Fire resistive coatings	350
Floor coatings	100
Form-release compounds	250
Graphic arts coatings (sign paints)	500
High temperature coatings	420
Industrial maintenance coatings	250
Low solids coatings	120
Magnesite cement coatings	450
Mastic texture coatings	100
Metallic pigmented coatings	500
Multicolor coatings	250
Pretreatment wash primers	420
Primers, sealers, and undercoaters	100
Reactive penetrating sealers	350
Recycled coatings	250
Roof coatings	50
Rust preventative coatings	250
Shellacs	
Clear	730
Opaque	550
Specialty primers, sealers and undercoaters	100
Stains	250
Stone consolidants	450
Swimming pool coatings	340
Traffic marking coatings	100
Tub and tile refinish coatings	420
Waterproofing membranes	250
Wood coatings	275
Wood preservatives	350
Zinc-rich primers	340

1. Grams of VOC per liter of coating, including water and including exempt compounds.
2. The specified limits remain in effect unless revised limits are listed in subsequent columns in the table.
3. Values in this table are derived from those specified by the California Air Resources Board, Architectural Coatings Suggested Control Measure, February 1, 2008. More information is available from the Air Resources Board.

14. Particleboard, medium density fiberboard (MDF) and hardwood plywood used in interior or exterior of the building shall comply with low formaldehyde emission standards as set forth in Table 4.504.5 below (4.504.5):

FORMALDEHYDE LIMITS ¹ (Maximum formaldehyde Emissions in Parts per Million)	
PRODUCT	LIMIT
Hardwood plywood veneer core	0.05
Hardwood plywood composite core	0.05
Particleboard	0.09
Medium density fiberboard	0.11
Thin medium density fiberboard ²	0.13

1. Values in this table are derived from those specified by the California Air Resources Board, Air Toxics Control Measure for Composite Wood as tested in accordance with ASTM E 1333-86(2002). For additional information, see California Code of Regulations, Title 17, Sections 83120 through 83120.12.
2. Thin medium density fiberboard has a maximum thickness of 5/16 inch (8 mm).

15. All duct and other related air distribution component openings shall be covered with tape, plastic, sheet metal or other methods acceptable to the building inspector to reduce the amount of water, dust and debris, which may enter the system until final startup of the HVAC equipment. (4.504.1)

16. Bathroom exhaust fans shall be ENERGY STAR compliant and be ducted to terminate outside the building. Unless functioning as a component of whole house ventilation system, fans must be controlled by a humidity control capable of adjustment between a relative humidity rage of less than or equal to 50% to maximum 80%. (4.506.1)

17. Duct systems are sized, designed and equipment is selected using the following methods (4.507.2):

- a. Establish heat loss and heat gain values according to ANSI/ACCA 2 Manual J-2011 (Residential Load Calculation), ASHRAE handbooks or equivalent design methods.
- b. Size duct systems according to ANSI/ACCA 1 Manual D-2014 (Residential Duct Systems), ASHRAE handbooks or other equivalent design software or methods.
- c. Select heating and cooling equipment according to ANSI/ACCA 3 Manual S-2014 (Residential Equipment Selection) or other equivalent design software or methods

Installer and Special Inspector Qualifications

18. HVAC system installers shall be trained and certified or work under direct supervision of trained and certified installers in the proper installation of HVAC systems. (702.1)

19. HVAC special inspectors must be qualified and able to demonstrate competence in the discipline they are inspecting. (702.2)

Documentations

20. An operation and maintenance manual, CD, web-based reference or other approved media shall be provided by the builder to the building occupant or owner at the final inspection. It shall include operation and maintenance instruction of the equipment and appliances. (4.410.1)

21. Documentation shall be provided to verify that finish materials used comply with VOC limits as set forth in Tables 4.504.1, 4.504.2, & 4.504.3. (4.504.2.4)

22. Documentation shall be provided to verify that composite wood products used comply with formaldehyde limits as set forth in Tables 4.504.5. (4.504.5.1)

23. Documentation which shows compliance with CAL Green code including construction documents, plans, specifications, builder or installer certification, and inspection reports and verification shall be available at the final inspection. (703.1)

24. CAL Green Documentation Compliance Certification form (City form) is required to be submitted to the Building Inspector prior to final building inspection. (Section 703.1)

NOTE: FOR BUILDING DEPT & GC USE AS MANY
ITEMS MAY NOT APPLY TO THIS PROJECT

Contractor shall exercise the responsibility with architect in securing latest approved dwgs. prior to actually executing work

REVISIONS NO.

1 City resubmittal 4-20-20

JOHN A. SALAT ARCHITECTS

22386 Woodgrove Road, Lake Forest, CA 92630
PH 949-235-4847 email: freaingrinds@earthlink.net

z e n a r c h i t e c t . c o m

architect


GOODING RESIDENCE
ROOM ADDITION/REMODEL
CALIFORNIA GREEN CODE

OWNER/SITE ADDRESS:

CONTACT: Kurt Gooding
24722 Jeremiah DR.

Dana Point, CA 92629

(949) 302-1070 Email: kurt.gooding@gmail.com

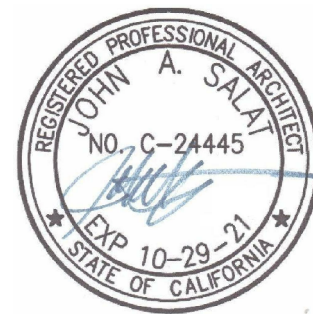

DRAWN

5

CHECKED

5

DATE

SEE REVISION BOX ABOVE FOR DNE

SCALE

AS NOTED ON PLANS

JOB NO.

SHEET

CGC-1

CERTIFICATE OF COMPLIANCE
Project Name: Gooding Remodel
Calculation Description: Title 24 Analysis
Calculation Date/Time: 2020-03-06T13:19:27-07:00
Input File Name: 24722JeremiahGooding.rbd19x
CF1R-PRF-01E
(Page 1 of 11)

GENERAL INFORMATION										
01	Project Name	Gooding Remodel								
02	Run Title	Title 24 Analysis								
03	Project Location	24722 Jeremiah Dr								
04	City	Dana Point								
05	Zip code	92629								
06	Climate Zone	5								
07	Building Type	Single-Family								
08	Project Scope	Addition/Alteration								
09	New Cond. Floor Area (ft ²)	0								
10	Existing Cond. Floor Area (ft ²)	1419								
11	Total Cond. Floor Area (ft ²)	1419								
12	ADU Bedroom Count	n/a								

COMPLIANCE RESULTS										
01	Building Complies with Computer Performance									
02	This building incorporates features that require field testing and/or verification by a certified HERS rater under the supervision of a CEC-approved HERS provider.									
03	Building does not incorporate Special Features									

ENERGY USE SUMMARY				
Energy Use (kBtu/ft ² -yr)	Standard Design	Proposed Design	Compliance Margin	Percent Improvement
Space Heating	11.36	8.75	-4.63	34.6
Space Cooling	18.15	27.29	-9.14	-50.4
W/L Ventilation	0	0	0	
Water Heating	19.87	14.1	-5.77	29
Self Utilization Credit	n/a	0	0	n/a
Compliance Energy Total	51.4	50.14	1.26	2.5

Registration Number: 420-PO10027014A-000-000-0000000-0000
Registration Date/Time: 03/09/2020 07:04
HERS Provider: Cal Energy
CA Building Energy Efficiency Standards - 2019 Residential Compliance
Report Version: 2019.1.100
Schema Version: rev 20190401
Report Generated: 2020-03-06 12:20:03

CERTIFICATE OF COMPLIANCE
Project Name: Gooding Remodel
Calculation Description: Title 24 Analysis
Calculation Date/Time: 2020-03-06T13:19:27-07:00
Input File Name: 24722JeremiahGooding.rbd19x
CF1R-PRF-01E
(Page 2 of 11)

REQUIRED SPECIAL FEATURES										
The following are features that must be installed as condition for meeting the modeled energy performance for this computer analysis.										
* NO SPECIAL FEATURES REQUIRED										

HERS FEATURE SUMMARY										
The following is a summary of the features that must be field-verified by a certified HERS Rater as a condition for meeting the modeled energy performance for this computer analysis. Additional detail is provided in the building tables below. Registered CF2Rs and CF3Rs are required to be completed in the HERS Registry										
Building-Level Verifications:										
• Verified Existing Conditions										
Cooling System Verifications:										
• Verified EER										
• Verified SEER										
• Verified Refrigerant Charge										
Heating System Verifications:										
• None										
HVAC Distribution System Verifications:										
• Duct Sealing required if a duct system component, plenum, or air handling unit is altered										
Domestic Hot Water System Verifications:										
• None										

BUILDING - FEATURES INFORMATION						
01	02	03	04	05	06	07
Project Name	Conditioned Floor Area (ft ²)	Number of Dwelling Units	Number of Bedrooms	Number of Zones	Number of Ventilation Cooling Systems	Number of Water Heating Systems
Gooding Remodel	1419	1	2	1	0	1

ZONE INFORMATION						
01	02	03	04	05	06	07
Zone Name	Zone Type	HVAC System Name	Zone Floor Area (ft ²)	Avg. Ceiling Height	Water Heating System 1	Water Heating System 2
House	Conditioned	New HVAC	1419	12	New DHW System	N/A

Registration Number: 420-PO10027014A-000-000-0000000-0000
Registration Date/Time: 03/09/2020 07:04
HERS Provider: Cal Energy
CA Building Energy Efficiency Standards - 2019 Residential Compliance
Report Version: 2019.1.100
Schema Version: rev 20190401
Report Generated: 2020-03-06 12:20:03

CERTIFICATE OF COMPLIANCE
Project Name: Gooding Remodel
Calculation Description: Title 24 Analysis
Calculation Date/Time: 2020-03-06T13:19:27-07:00
Input File Name: 24722JeremiahGooding.rbd19x
CF1R-PRF-01E
(Page 3 of 11)

OPAQUE SURFACES										
01	02	03	04	05	06	07	08	09	10	11
Name	Zone	Construction	Area (ft ²)	Orientation	Gross Area (ft ²)	Window and Door Area (ft ²)	Tilt (deg)	Status	Verified Existing Condition	Existing Construction
Front Wall	House	Default Wall 1978 to 1991	0	Front	283	63.5	90	Existing	No	
Ex 45 Wall	House	Default Wall 1978 to 1991	45	n/a	20	6.7	90	Existing	No	
Ex Left Wall	House	Default Wall 1978 to 1991	90	Left	370	66.7	90	Existing	No	
Ex Rear Wall	House	Default Wall 1978 to 1991	180	Back	530	135	90	Existing	No	
Ex Right Wall	House	Default Wall 1978 to 1991	270	Right	750	36.3	90	Existing	No	
Ex 315 Wall	House	Default Wall 1978 to 1991	315	n/a	20	6.7	90	Existing	No	
Wall to Garage	House - Garage	Default Wall 1978 to 1991	n/a	n/a	260	18	n/a	Existing	No	
Ex Roof 1	House	Default Roof 1978 to Pres	n/a	n/a	710	n/a	n/a	Existing	No	
Ex Roof 2 2	House	Default Roof 1978 to Pres	n/a	n/a	686	n/a	n/a	Existing	No	
Gar Roof	Garage	8-0 Roof Attic	n/a	n/a	454	n/a	n/a	Existing	No	
Gar Front Wall	Garage	8-0 Wall	0	Front	180	0	90	Existing	No	
Gar Left Wall	Garage	8-0 Wall	90	Left	150	0	90	Existing	No	
Gar Right Wall	Garage	8-0 Wall	270	Right	170	0	90	Existing	No	

Registration Number: 420-PO10027014A-000-000-0000000-0000
Registration Date/Time: 03/09/2020 07:04
HERS Provider: Cal Energy
CA Building Energy Efficiency Standards - 2019 Residential Compliance
Report Version: 2019.1.100
Schema Version: rev 20190401
Report Generated: 2020-03-06 12:20:03

CERTIFICATE OF COMPLIANCE
Project Name: Gooding Remodel
Calculation Description: Title 24 Analysis
Calculation Date/Time: 2020-03-06T13:19:27-07:00
Input File Name: 24722JeremiahGooding.rbd19x
CF1R-PRF-01E
(Page 4 of 11)

OPAQUE SURFACES - CATHEDRAL CEILINGS													
01	02	03	04	05	06	07	08	09	10	11	12	13	14
Name	Zone	Type	Area (ft ²)	Orientation	Area (ft ²)	Skylight Area (ft ²)	Roof Rise (x in 12)	Roof Reflectance	Roof Emissivity	Cool Roof	Status	Verified Existing Condition	Existing Construction
Ex Roof 2	House	Default Roof 1978 to Pres	270	Right	24.1	24	4.5	0.1	0.85	No	Existing	No	

ATTIC									
01	02	03	04	05	06	07	08	09	10
Name	Construction	Type	Roof Rise (x in 12)	Roof Reflectance	Roof Emissivity	Radiant Barrier	Cool Roof	Status	Verified Existing Condition
Attic House	Attic Roof/House	Ventilated	4.5	0.1	0.85	No	No	Existing	No
Attic - Garage	Attic Garage Roof Cms	Ventilated	0	0.1	0.85	No	No	Existing	No

FENESTRATION / GLAZING															
01	02	03	04	05	06	07	08	09	10	11	12	13	14	15	16
Name	Type	Surface	Orientation	Area (ft ²)	Width (ft)	Height (ft)	Mult.	Area (ft ²)	U-factor	U-factor Source	SHGC	SHGC Source	Exterior Shading	Status	Verified Existing Condition
Ex Front Windows	Window	Front Wall	Front	0		1	43.3	1.39	Tables 110.6-A and 110.6-B	0.83	Tables 110.6-A and 110.6-B	0.83	Bug Screen	Existing	No
Ex Bay Left	Window	Ex 45 Wall		45		1	6.7	1.39	Tables 110.6-A and 110.6-B	0.83	Tables 110.6-A and 110.6-B	0.83	Bug Screen	Existing	No
New Left Doors	Window	Ex Left Wall	Left	90		1	66.7	0.55	Tables 110.6-A and 110.6-B	0.67	Tables 110.6-A and 110.6-B	0.67	Bug Screen	New	n/a

Registration Number: 420-PO10027014A-000-000-0000000-0000
Registration Date/Time: 03/09/2020 07:04
HERS Provider: Cal Energy
CA Building Energy Efficiency Standards - 2019 Residential Compliance
Report Version: 2019.1.100
Schema Version: rev 20190401
Report Generated: 2020-03-06 12:20:03

CERTIFICATE OF COMPLIANCE
Project Name: Gooding Remodel
Calculation Description: Title 24 Analysis
Calculation Date/Time: 2020-03-06T13:19:27-07:00
Input File Name: 24722JeremiahGooding.rbd19x
CF1R-PRF-01E
(Page 5 of 11)

FENESTRATION / GLAZING															
01	02	03	04	05	06	07	08	09	10	11	12	13	14	15	16
Name	Type	Surface	Orientation	Area (ft ²)	Width (ft)	Height (ft)	Mult.	Area (ft ²)	U-factor	U-factor Source	SHGC	SHGC Source	Exterior Shading	Status	Verified Existing Condition
Ex SGD	Window	Ex Rear Wall	Back	180		1	53.3	1.39	Tables 110.6-A and 110.6-B	0.83	Tables 110.6-A and 110.6-B	0.83	Bug Screen	Existing	No
New Rear Doors	Window	Ex Rear Wall	Back	180		1	66.7	0.55	Tables 110.6-A and 110.6-B	0.67	Tables 110.6-A and 110.6-B	0.67	Bug Screen	New	n/a
Ex Window 5	Window	Ex Rear Wall	Back	180		1	15	1.39	Tables 110.6-A and 110.6-B	0.83	Tables 110.6-A and 110.6-B	0.83	Bug Screen	Existing	No
Ex Right Windows	Window	Ex Right Wall	Right	270		1	36.3	1.39	Tables 110.6-A and 110.6-B	0.83	Tables 110.6-A and 110.6-B	0.83	Bug Screen	Existing	No
Ex Bay Right	Window	Ex 315 Wall		315		1	6.7	1.39	Tables 110.6-A and 110.6-B	0.83	Tables 110.6-A and 110.6-B	0.83	Bug Screen	Existing	No
Skylight	Skylight	Ex Roof 2	Right	270		1	24	1.47	Tables 110.6-A and 110.6-B	0.76	Tables 110.6-A and 110.6-B	0.76	None	New	n/a

DOOR/DOORS					
01	02	03	04	05	06
Name	Side of Building	Area (ft ²)	U-factor	Status	Verified Existing Condition
Door A	Front Wall	20	0.5	New	n/a
Door to Garage	Wall to Garage	18	0.5	New	n/a

Registration Number: 420-PO10027014A-000-000-0000000-0000
Registration Date/Time: 03/09/2020 07:04
HERS Provider: Cal Energy
CA Building Energy Efficiency Standards - 2019 Residential Compliance
Report Version: 2019.1.100
Schema Version: rev 20190401
Report Generated: 2020-03-06 12:20:03

CERTIFICATE OF COMPLIANCE
Project Name: Gooding Remodel
Calculation Description: Title 24 Analysis
Calculation Date/Time: 2020-03-06T13:19:27-07:00
Input File Name: 24722JeremiahGooding.rbd19x
CF1R-PRF-01E
(Page 6 of 11)

SLAB FLOORS								
01	02	03	04	05	06	07	08	09
Name	Zone	Area (ft ²)	Perimeter (ft)	Edge Insul. R-value and Depth	Carpeted Fraction	Heated	Status	Verified Existing Condition
Ex Slab	House	1419	140	None	80%	No	Existing	No
Gar Slab	Garage	454	60	None	0%	No	Existing	No

OPAQUE SURFACE CONSTRUCTIONS							
01	02	03	04	05	06	07	08
Construction Name	Surface Type	Construction Type	Framing	Total Cavity R-value	Interior / Exterior Continuous R-value	U-factor	Assembly Layers
8-0 Wall	Exterior Walls	Wood Framed Wall	2x4 @ 16 in. O. C.	R-0	None / None	0.361	Inside Finish: Gypsum Board Cavity / Frame: no insul. / 2x4 Exterior Finish: 3 Coat Stucco
Default Wall 1978 to 1991	Exterior Walls	Wood Framed Wall	2x4 @ 16 in. O. C.	R-11	None / None	0.11	Inside Finish: Gypsum Board Cavity / Frame: R-11 / 2x4 Exterior Finish: 3 Coat Stucco
Default Roof 1978 to Pres	Cathedral Ceilings	Wood Framed Ceiling	2x4 @ 16 in. O. C.	R-19	None / None	0.061	Roofing: Light Roof (Asphalt Shingle) Roof Deck: Wood Siding/heating/Decking Cavity / Frame: R-19 / 2x4 Inside Finish: Gypsum Board
Default Wall 1978 to 1991	Interior Walls	Wood Framed Wall	2x4 @ 16 in. O. C.	R-11	None / None	0.099	Inside Finish: Gypsum Board Cavity / Frame: R-11 / 2x4 Other Side Finish: Gypsum Board
Attic Garage Roof Cons	Attic Roofs	Wood Framed Ceiling	2x4 Top Chord of Roof Truss @ 24 in. O. C.	R-0	None / None	0.644	Roofing: Light Roof (Asphalt Shingle) Roof Deck: Wood Siding/heating/Decking Cavity / Frame: no insul. / 2x4 Top Chrd

CERTIFICATE OF COMPLIANCE
Project Name: Gooding Remodel
Calculation Description: Title 24 Analysis

Calculation Date/Time: 2020-03-06T13:19:27-07:00
Input File Name: 24722JeremiahGooding.rbd19x

CF1R-PRF-01E
(Page 7 of 11)

01	02	03	04	05	06	07	08
Construction Name	Surface Type	Construction Type	Framing	Total Cavity R-value	Interior / Exterior Continuous R-value	U-factor	Assembly Layers
Attic Roof/House	Attic Roofs	Wood Framed Ceiling	2x4 Top Chord of Roof Truss @ 24 in. O.C.	R-0	None / None	0.044	Roofing: Light Roof (Asphalt Shingle) Roof Deck: Wood Siding/Sheathing/Decking Cavity / Frame: no insul. / 2x4 Top Chrd
R-O Roof Attic	Ceilings (below attic)	Wood Framed Ceiling	2x4 @ 24 in. O.C.	R-0	None / None	0.481	Cavity / Frame: no insul. / 2x4 Inside Finish: Gypsum Board
Default Roof 1978 to Pres	Ceilings (below attic)	Wood Framed Ceiling	2x4 @ 16 in. O.C.	R-19	None / None	0.049	Over Ceiling Joists: R-9.9 insul. Cavity / Frame: R-9.1 / 2x4 Inside Finish: Gypsum Board

01	02	03	04
Quality Insulation Installation (QI)	Quality Installation of Spray Foam Insulation	Building Envelope Air Leakage	CFM50
Not Required	Not Required	Not Required	n/a

01	02	03	04	05	06	07	08	09	10
Name	System Type	Distribution Type	Water Heater Name (1)	Solar Reaction (%)	Compact Distribution	HERS Verification	Status	Verified Existing Condition	Existing Water Heating System
New DHW System	Domestic Hot Water (DHW)	Standard Distribution System	Tankless (1)	n/a	None	n/a	Altered	Yes	

Registration Number: 420-P010027014A-000-000-0000000-0000
CA Building Energy Efficiency Standards - 2019 Residential Compliance
Registration Date/Time: 03/09/2020 07:54
Report Version: 2019.1.100
Schema Version: rev 20190401
HERS Provider: Cal Energy
Report Generated: 2020-03-06 12:20:03

CERTIFICATE OF COMPLIANCE
Project Name: Gooding Remodel
Calculation Description: Title 24 Analysis

Calculation Date/Time: 2020-03-06T13:19:27-07:00
Input File Name: 24722JeremiahGooding.rbd19x

CF1R-PRF-01E
(Page 8 of 11)

01	02	03	04	05	06	07	08	09	10	11	12	13	14
Name	Heating Element Type	Tank Type	# Units	Tank Vol. (gal)	Energy Factor or Efficiency	Input Rating or Pilot	Tank Insulation R-value (in./ft.)	Standby Loss or Recovery EER	1st Hc. Rating or Flow Rate	NEEA Heat Pump Brand or Model / Other	Tank Location or Ambient Condition	Status	Verified Existing Condition
Tankless	Natural Gas	Consumer Instantaneous	1	0	0.9 UEF	200000 Btu/Hr	0	n/a	n/a	n/a	n/a	Altered	Yes

01	02	03	04	05	06	07	08
Name	Pipe Insulation	Parallel Piping	Compact Distribution	Compact Distribution Type	Recirculation Control	Central DHW Distribution	Shower Drain Water Heat Recovery
New DHW System - 1/1	Not Required	Not Required	Not Required	None	Not Required	Not Required	Not Required

01	02	03	04	05	06	07	08	09	10	11	12
Name	System Type	Heating Unit Name	Cooling Unit Name	Fan Name	Distribution Name	Required Thermostat Type	Heating Equipment Count	Cooling Equipment Count	Status	Verified Existing Condition	Existing HVAC System
New HVAC	Heating and cooling system other	Heating Component 1	Cooling Component 1	HVAC Fan 1	Air Distribution System 1	Setback	1	1	New	No	n/a

01	02	03	04	05
Name	System Type	Number of Units	Heating Efficiency Type	Efficiency
Heating Component 1	Central gas furnace	1	AFUE	90

Registration Number: 420-P010027014A-000-000-0000000-0000
CA Building Energy Efficiency Standards - 2019 Residential Compliance
Registration Date/Time: 03/09/2020 07:54
Report Version: 2019.1.100
Schema Version: rev 20190401
HERS Provider: Cal Energy
Report Generated: 2020-03-06 12:20:03

CERTIFICATE OF COMPLIANCE
Project Name: Gooding Remodel
Calculation Description: Title 24 Analysis

Calculation Date/Time: 2020-03-06T13:19:27-07:00
Input File Name: 24722JeremiahGooding.rbd19x

CF1R-PRF-01E
(Page 9 of 11)

01	02	03	04	05	06	07	08
Name	System Type	Number of Units	Efficiency EER	Efficiency SEER	Zonally Controlled	Multi-speed Compressor	HERS Verification
Cooling Component 1	Central split AC	1	12.5	15	Not Zonal	Single-Speed	Cooling Component 1-hera-cool

01	02	03	04	05	06
Name	Verified Airflow	Airflow Target	Verified EER	Verified SEER	Verified Refrigerant Charge
Cooling Component 1-hera-cool	Not Required	0	Required	Required	Required

01	02	03	04	05	06	07	08	09	10	11	12	13	14	15	16
Name	Type	Design Type	Supply	Return	Supply	Return	Supply	Return	Bypass Duct	Duct Leakage	HERS Verification	Status	Verified Existing Condition	Existing Distribution system	New Ducts 40 ft.
Air Distribution System 1	Unconditioned attic	Non-Verified	R-6	R-6	Attic	Attic	n/a	n/a	No Bypass Duct	Existing (not specified)	Air Distribution System 1-hera-dist	Existing	No	n/a	n/a

01	02	03	04
Name	Type	Fan Power (Watts/CFM)	Name
HVAC Fan 1	HVAC Fan	0.45	HVAC Fan 1-hera-fan

Registration Number: 420-P010027014A-000-000-0000000-0000
CA Building Energy Efficiency Standards - 2019 Residential Compliance
Registration Date/Time: 03/09/2020 07:54
Report Version: 2019.1.100
Schema Version: rev 20190401
HERS Provider: Cal Energy
Report Generated: 2020-03-06 12:20:03

CERTIFICATE OF COMPLIANCE
Project Name: Gooding Remodel
Calculation Description: Title 24 Analysis

Calculation Date/Time: 2020-03-06T13:19:27-07:00
Input File Name: 24722JeremiahGooding.rbd19x

CF1R-PRF-01E
(Page 10 of 11)

01	02	03
Name	Verified Fan Watt Draw	Required Fan Efficiency (Watts/CFM)
HVAC Fan 1-hera-fan	Not Required	0

01	02	03	04
Name	Name	Number of Heaters	Distribution Type
Ex DHW System	Standard Distribution System	1	0

01	02	03	04	05	06	07	08
Name	Heater Element Type	Tank Type	Tank Volume (gal)	Energy Factor or Efficiency	Input Rating	Tank Exterior Insulation R-value	Standby Loss (fraction)
Ex DHW	Natural Gas	Small Storage	50	0.62 Energy Factor	75000	0	n/a

Registration Number: 420-P010027014A-000-000-0000000-0000
CA Building Energy Efficiency Standards - 2019 Residential Compliance
Registration Date/Time: 03/09/2020 07:54
Report Version: 2019.1.100
Schema Version: rev 20190401
HERS Provider: Cal Energy
Report Generated: 2020-03-06 12:20:03

CERTIFICATE OF COMPLIANCE
Project Name: Gooding Remodel
Calculation Description: Title 24 Analysis

Calculation Date/Time: 2020-03-06T13:19:27-07:00
Input File Name: 24722JeremiahGooding.rbd19x

CF1R-PRF-01E
(Page 11 of 11)

DOCUMENTATION AUTHORITY'S DECLARATION STATEMENT	
I, I certify that this Certificate of Compliance documentation is accurate and complete.	
Documentation Author Name: Denise Kowal	Documentation Author Signature: <i>Denise Kowal</i>
Company: Hummingbird Energy Services	Signature Date: 03/09/2020
Address: 14811 Starnum Way	City/State/Zip: Tuckee, CA 96161
RESPONSIBLE PERSON'S DECLARATION STATEMENT	
I certify the following under penalty of perjury, under the laws of the State of California: 1. I am eligible under Division 3 of the Business and Professions Code to accept responsibility for the building design identified on this Certificate of Compliance. 2. I certify that the energy features and performance specifications identified on this Certificate of Compliance conform to the requirements of Title 24, Part 1 and Part 6 of the California Code of Regulations. 3. The building design features or system design features identified on this Certificate of Compliance are consistent with the information provided on other applicable compliance documents, worksheets, calculations, plans and specifications submitted to the enforcement agency for approval with this building permit application.	
Responsible Designer Name: John Salat	Responsible Designer Signature: <i>John Salat</i>
Company: John A Salat Architects	Date Signed: 03/09/2020
Address: 22386 Woodgrove Rd Woodgrove Rd	City/State/Zip: Lake Forest, CA 92630
Phone: 949 354847	

NOTICE: This certificate has been generated by California Energy Registry, Inc. ("Cal Energy") using information uploaded by third parties not affiliated or related to Cal Energy. Therefore, Cal Energy is not responsible for, and cannot guarantee, the accuracy, completeness, or reliability of the information provided. It is unlawful/feasible and taken to full extent of law from claims arising of legal expense associated of misuse whether directly or indirectly related to this project. Drawings are not intended as record or actual installed construction, therefore wave responsibility for discrepancies.

Registration Number: 420-P010027014A-000-000-0000000-0000
CA Building Energy Efficiency Standards - 2019 Residential Compliance
Registration Date/Time: 03/09/2020 07:54
Report Version: 2019.1.100
Schema Version: rev 20190401
HERS Provider: Cal Energy
Report Generated: 2020-03-06 12:20:03

Contractor shall exercise the responsibility with architect in securing latest approved draws, prior to actually executing work

NO./REVISION/DATE
city submittal 3-7-20

JOHN A. SALAT ARCHITECTS
22386 Woodgrove Road, Lake Forest, CA 92630
PH 949-235-4847 email: freeingwinds@earthlink.net
z e n a r c h i t e c t . c o m

architect

GOODING RESIDENCE
ROOM ADDITION/REMODEL
TITLE 24 REPORT

OWNER/SITE ADDRESS:
CONTACT: Kurt Gooding
24722 Jeremiah DR.
Dana Point, CA 92629
(949) 302-1070 Email: kurt.gooding@gmail.com



DRAWN
5
CHECKED
5
DATE
SEE REVISION BOX ABOVE FOR DATE
SCALE
AS NOTED ON PLANS
JOB NO.
SHEET

T-24-2



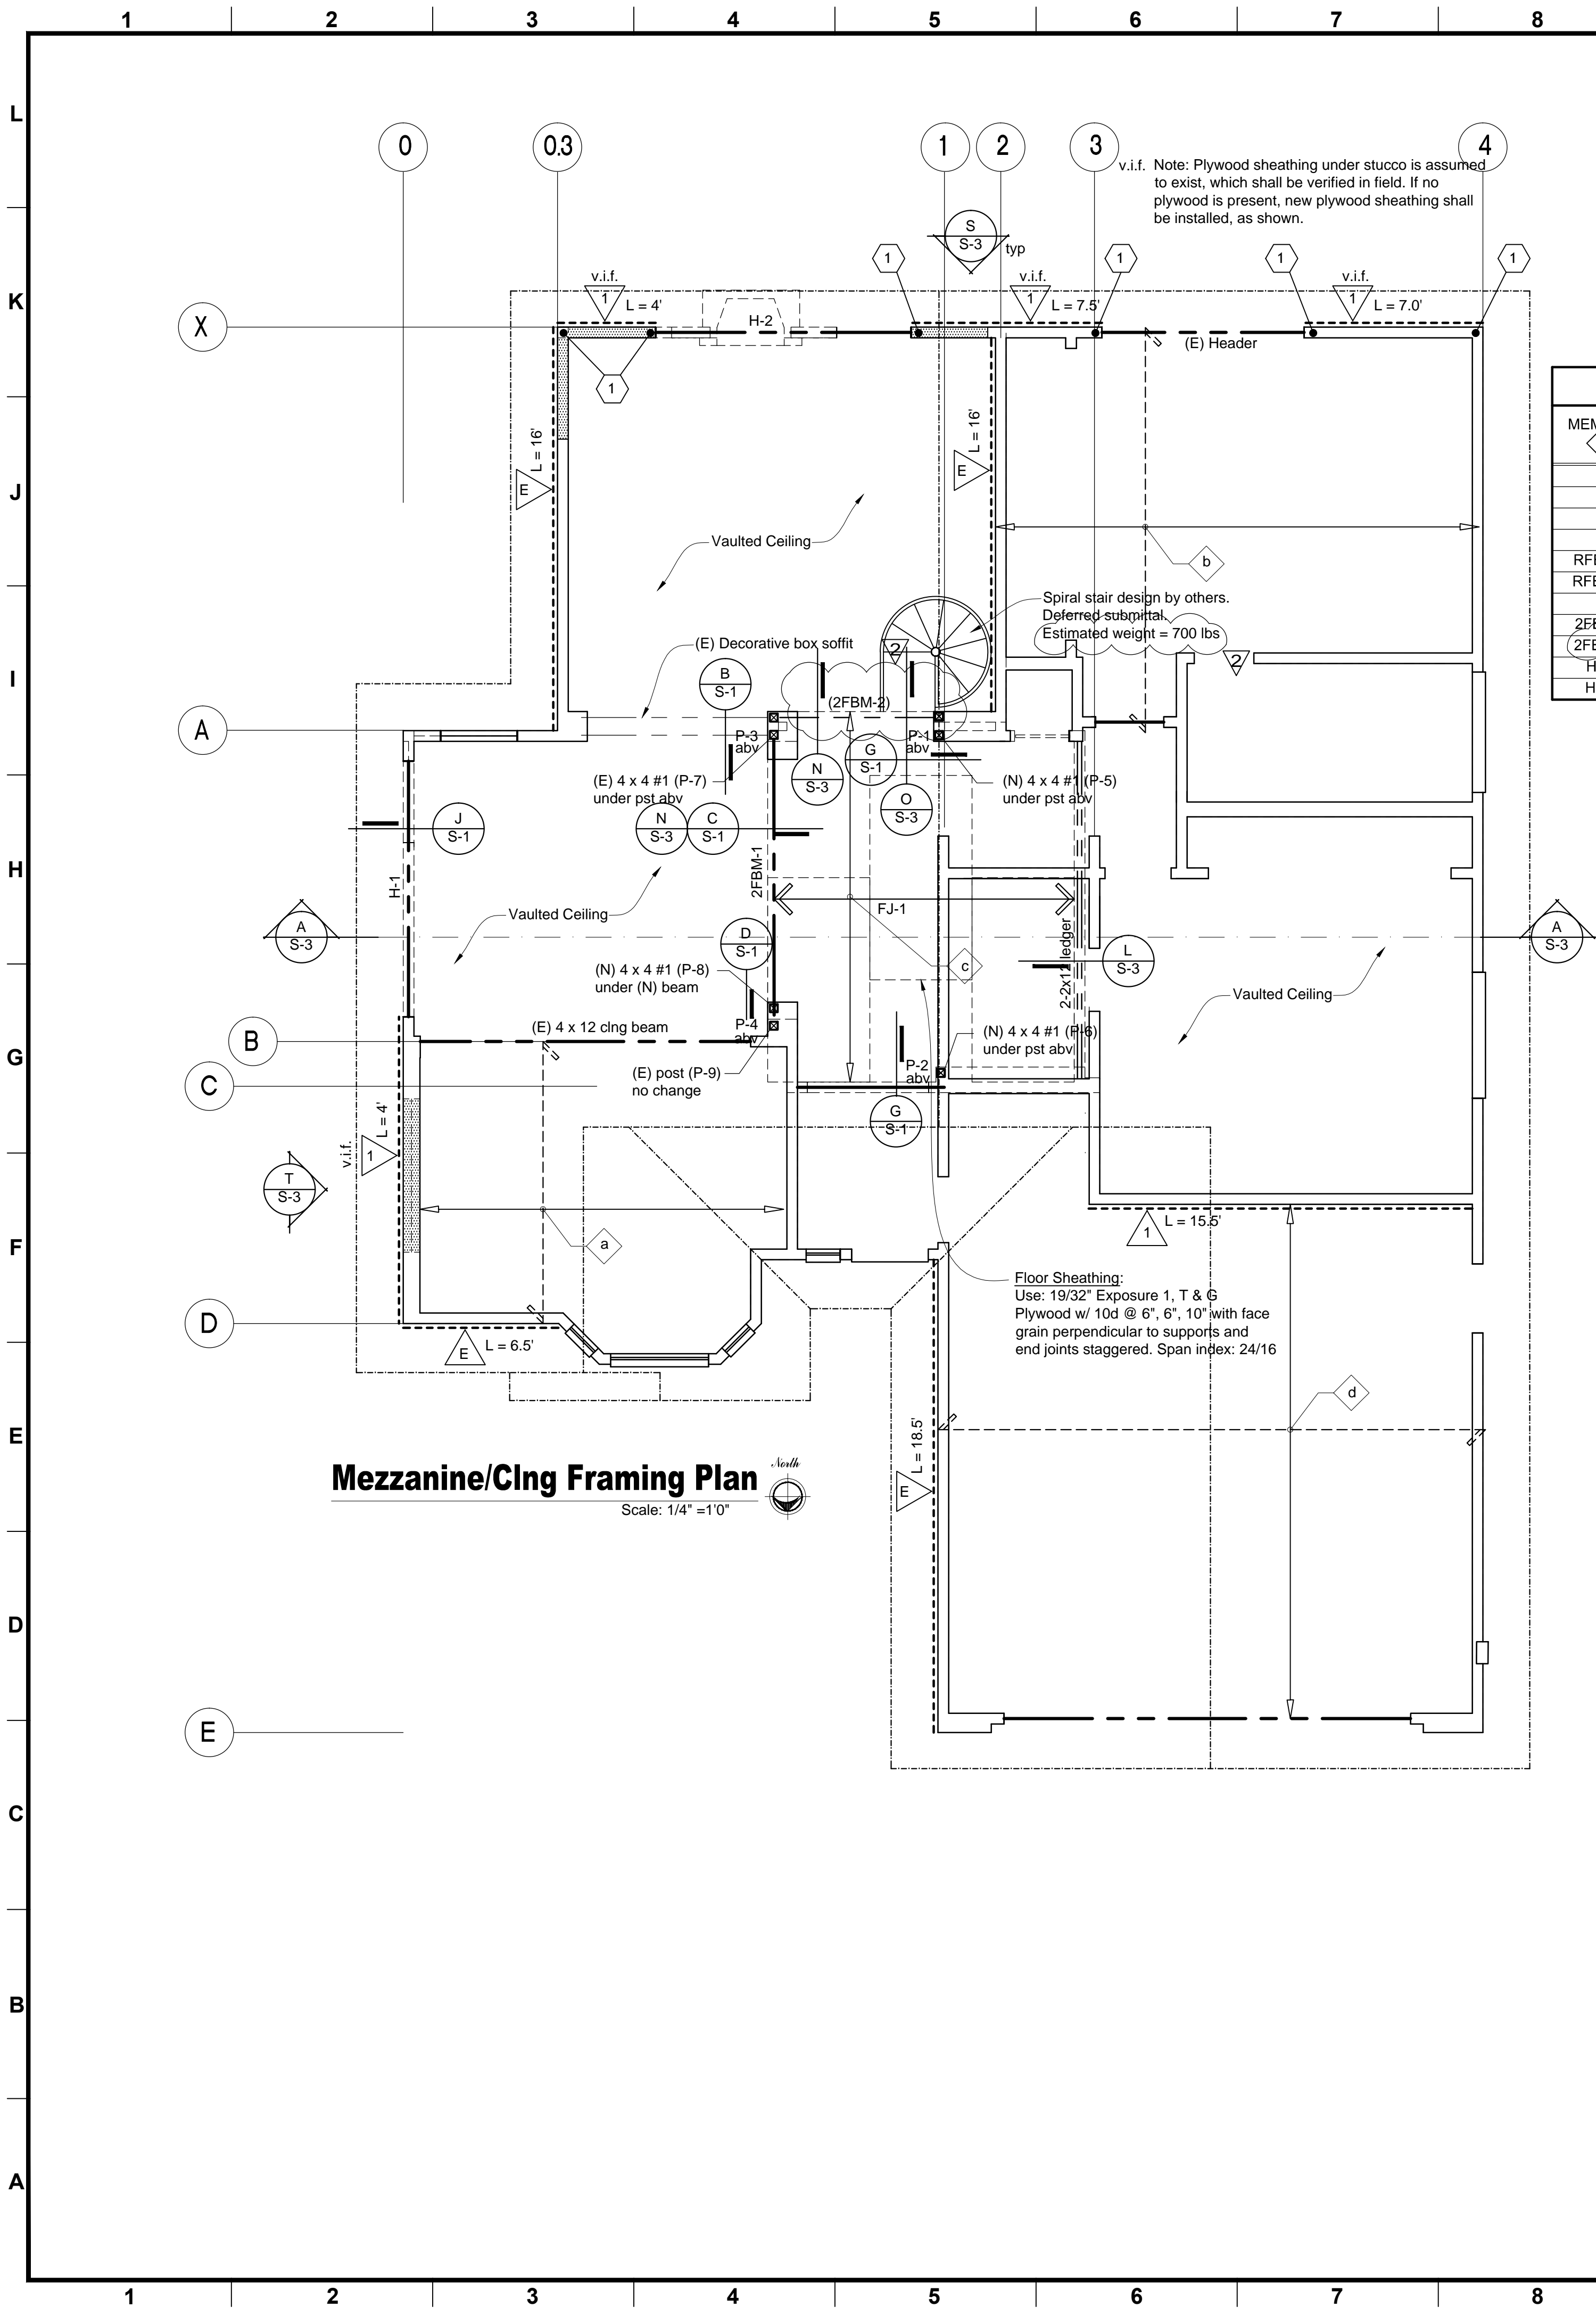


Table 4: FRAMING MEMBERS	
MEMBER ID	MEMBER SIZE
a	2 x 6 #2 or BTR DF-L CJs @ 16" o. c.
b	2 x 8 #2 or BTR DF-L RRs @ 16" o. c.
c	2 x 12 #2 or BTR DF-L FJs @ 16" o. c.
RFBM-1	(E) 4 x 12 #1, Drop Bm
RFBM-2	(N) 4 x 10 #1 min.
2FBM-1	(N) 4 x 12 #1
2FBM-2	(N) 4 x 12 #1
H-1	4 x 10 #1
H-2	4 x 8 #1

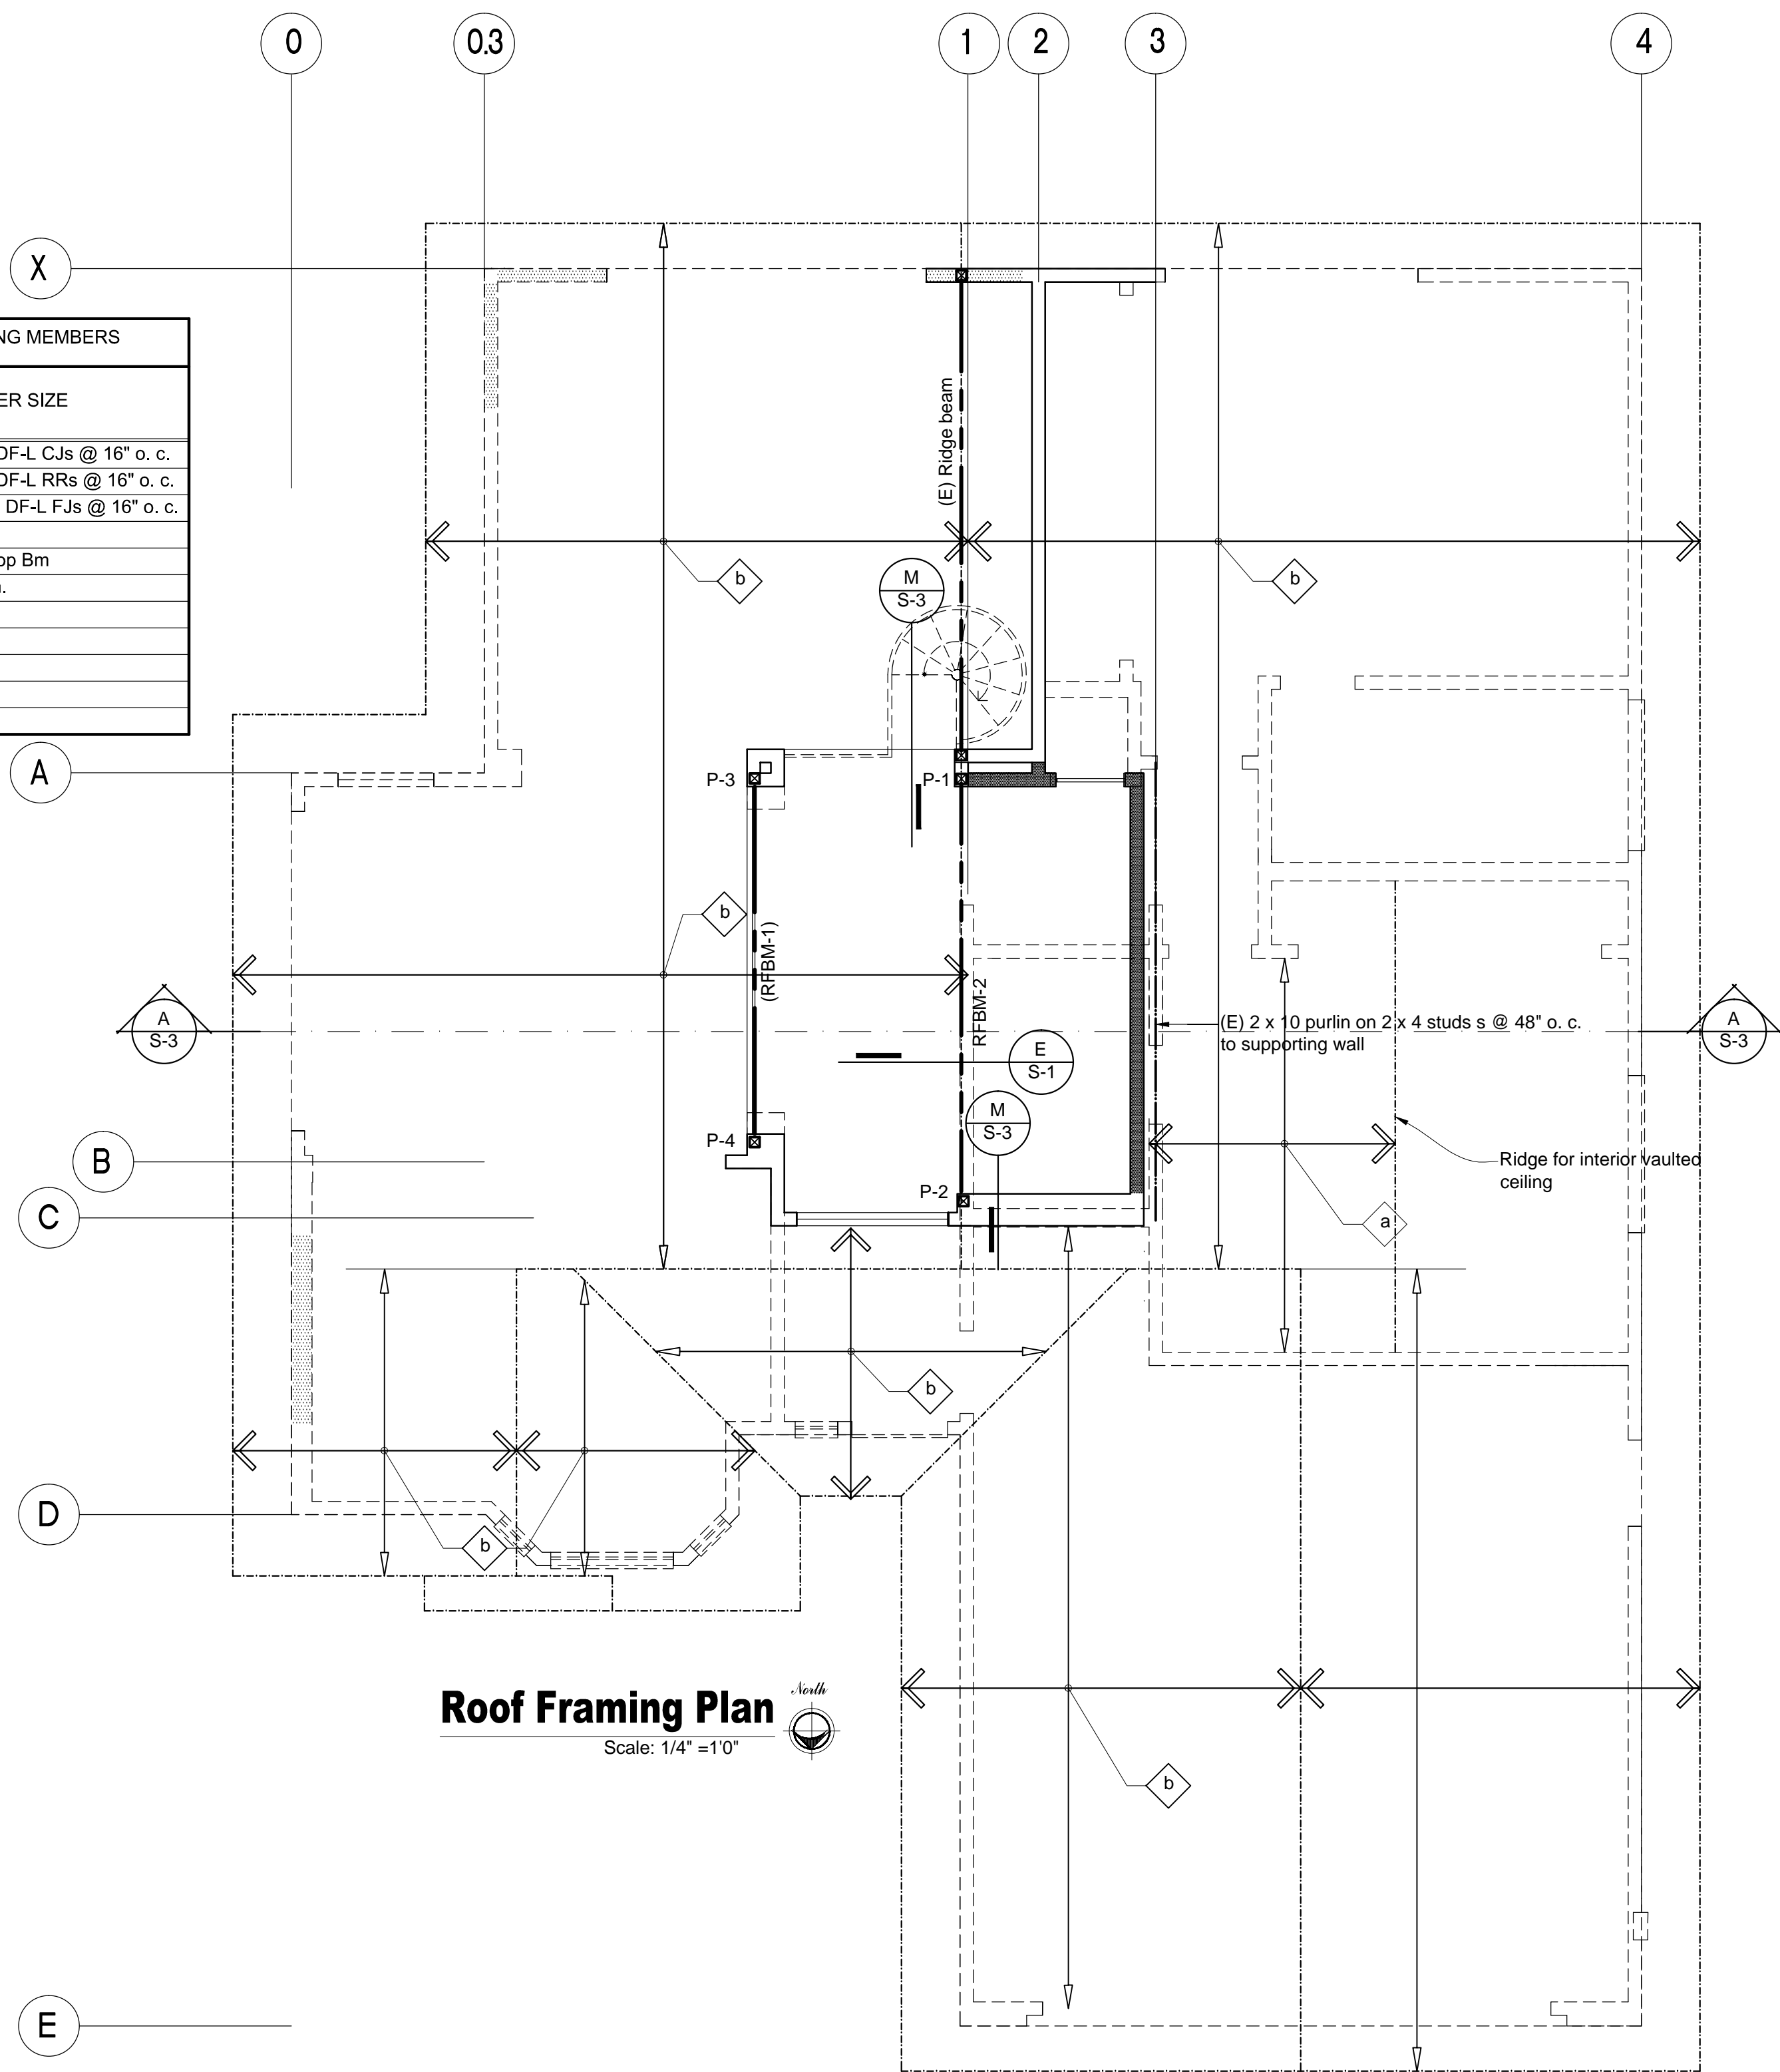

NO.	DESCRIPTION	DATE	BY
030120	City review	030120	CV
042020	Plan check corrections	042020	CV
062320	Plan check corrections	062320	CV

9234 Stamps Ave.
Downey, CA 90240
Tel (323) 236-7210
vegacpe@aol.com
Lic. No. CA3117

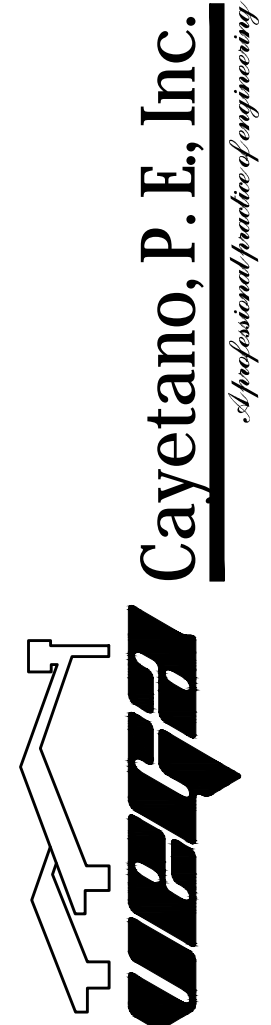

SHEET TITLE:	STRUCTURAL ROOF FRAMING PLAN
ADDRESS:	24722 Jeremiah Drive Dana Point, CA 92629
OWNER/CONTRACTOR:	

PROJECT NO. 19-180
SHEET

S-2
OF 4 SHEETS



CITY OF DANA POINT
COMMUNITY DEVELOPMENT
BUILDING AND SAFETY
33282 Golden Lantern, Suite 209
Dana Point, CA 92629
949 248-3594
www.danapoint.org

A041 - STATEMENT

2016 CALIFORNIA CODES
CODE CYCLE

01/01/2017
EFFECTIVE DATE

STATEMENT OF SPECIAL INSPECTIONS & STRUCTURAL OBSERVATIONS

ADDRESS 24722 Jeremiah Drive, Dana Point, CA 92629 PERMIT NUMBER BLD20-0414
OWNER Kurt Gooding
RDP* Cayetano G. Vega PE
* Registered Design Professional or Engineer of Record

STATEMENT OF SPECIAL INSPECTIONS

The applicant shall submit a statement of Special Inspections in accordance with Section 107.1, Chapter 1, Division II, as a condition for permit issuance. This statement shall be in accordance with Section 1704.3.

The Special Inspection and Structural Testing requirements of the Building Code included in this document are:

- Designation of Special Inspectors, Structural Observers, & Testing Agencies.
- Schedule of Special Inspections.
- Schedule of Structural Observations.

See sheet SD-1

DESIGNATION OF SPECIAL INSPECTORS, STRUCTURAL OBSERVATIONS, & TESTING AGENCIES

The Owner or the Registered Design Professional in responsible charge acting as the Owner's Agent shall employ one or more approved agencies to perform inspections during construction on the type of work listed under Section 1705. These inspections are in addition to the City of Dana Point inspections identified in Section 110.

Deputy Inspectors shall be registered with the City of Dana Point.

The Special Inspectors, Structural Observers, and Testing Agencies shall keep records of all inspections and tests, and furnish reports to the Building Official and the Registered Design Professional in Responsible Charge (RDP). Discovered discrepancies shall be brought to the immediate attention of the Contractor for correction. If such discrepancies are not corrected, the discrepancies shall be brought to the attention of the Building Official and the RDP. Special Inspectors and Structural Observers shall refer to the approved plans for detailed inspection requirements.

The following individuals or firms will be performing the required inspections and testing.

<u>Cayetano Vega PE</u>	<u>C-43117</u>
<small>Designated Structural Observer or Deputy Inspector</small>	<small>Registration Number</small>
<u>Mario Hernandez, deputy insp. Conc.</u>	<u>902</u>
<small>Designated Structural Observer or Deputy Inspector</small>	<small>Registration Number</small>
<small>Designated Structural Observer or Deputy Inspector</small>	<small>Registration Number</small>

A041-STATEMENT

Page 1

FINAL REPORT OF SPECIAL INSPECTIONS

At the conclusion of the work included in the permit, the structural observer shall submit to the Building Official a written statement that the site visits have been made and identify any reported deficiencies which, to the best of the structural observer's knowledge, have been resolved.

Structural observation shall be provided in Seismic Design Category D, E or F when one of the following conditions exists:

1. The structure is classified as Risk Category III or IV in accordance with Table 1604.5.
2. The height of the structure is greater than 75 feet above the base.
3. The structure is assigned to Seismic Design Category E, is classified as Risk Category I or II in accordance with Table 1604.5 and is greater than 2 stories above grade plane.
4. When so designated by the registered design professional responsible for the structural design.
5. When such observation is specifically required by the Building Official, or when the construction involves:
 1. In FP-3 Zone.
 2. Hillside Construction
 3. Steel or concrete moment frames
 4. Caisson/Grade Beam Construction

Prior to the commencement of observations, the structural observer shall submit to the Building Official a written statement identifying the frequency and extent of the structural observations.

Prepared by:

Cayetano Vega PE

(Type or print name)

Cayetano Vega

Signature

06 / 23 / 20

Date

Owner's Authorization:

Building Official's Acceptance:

Signature

Date







Signature

Date




A041-STATEMENT

Page 2

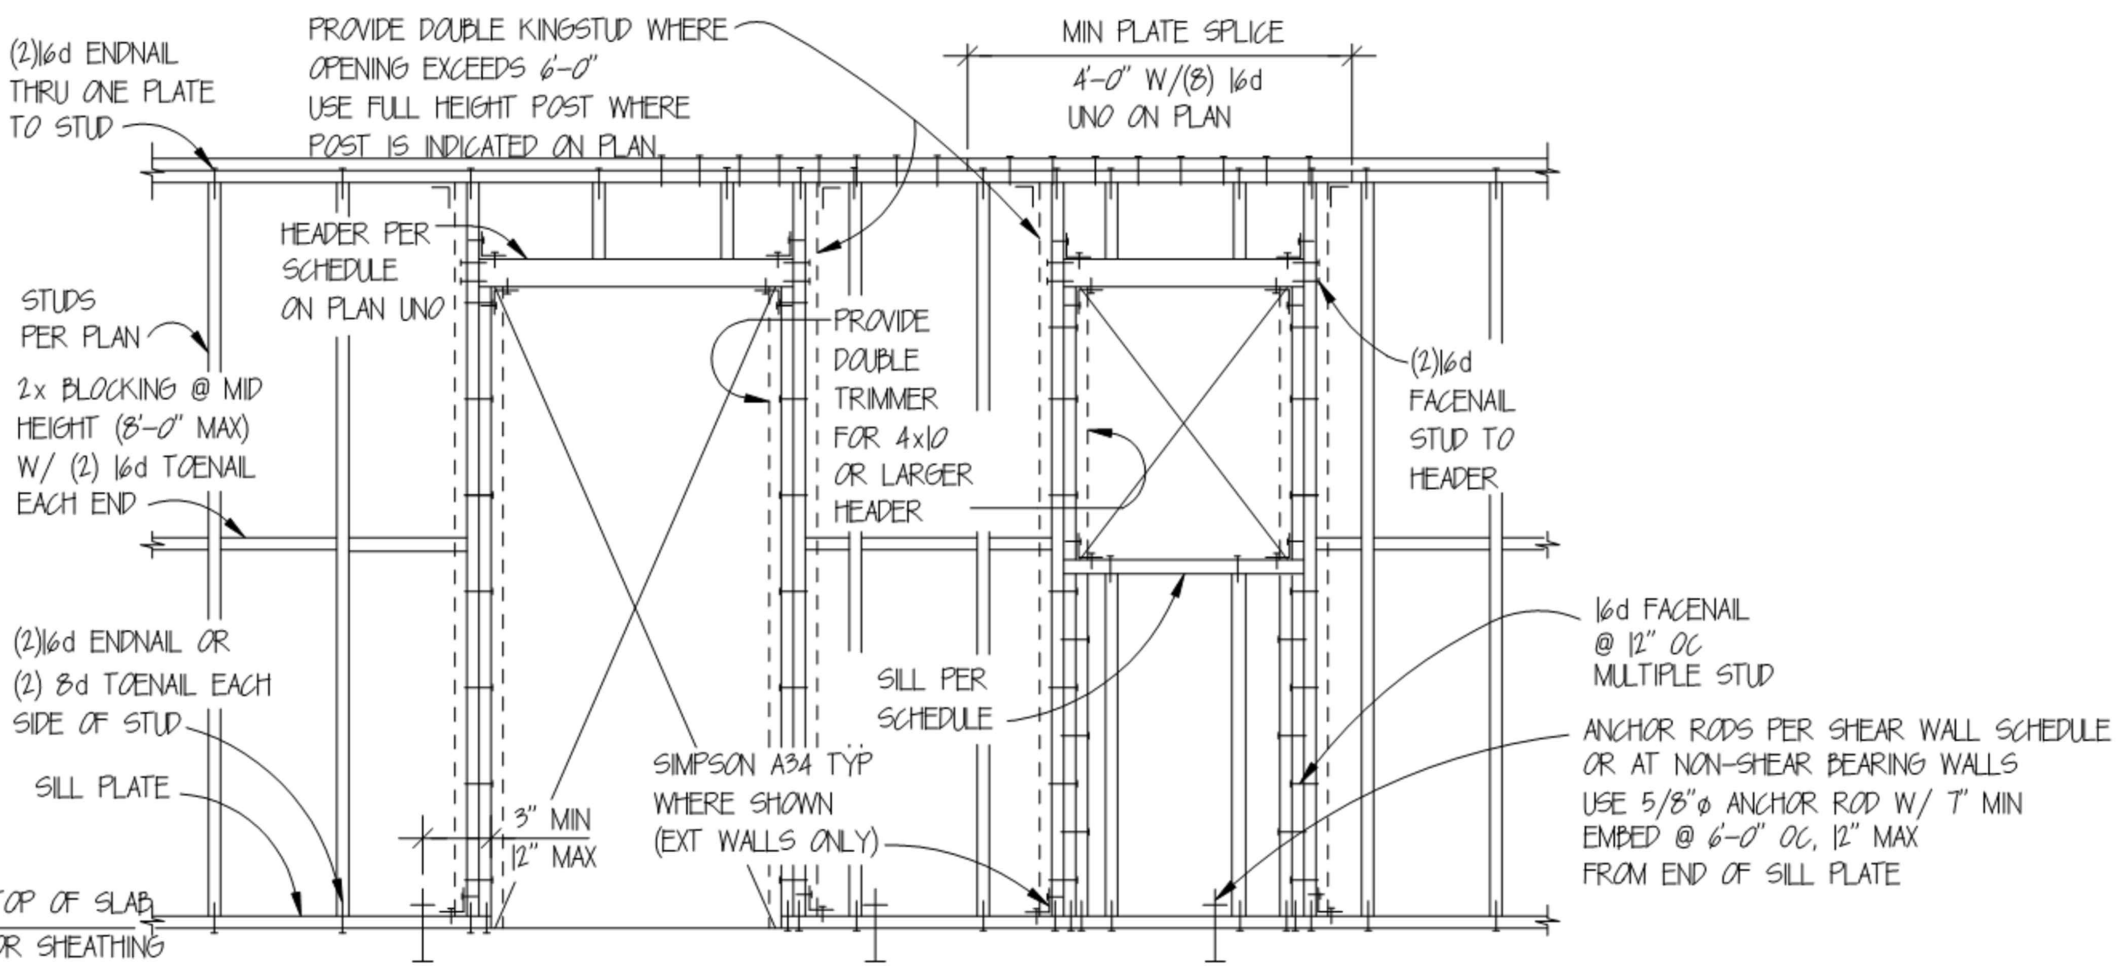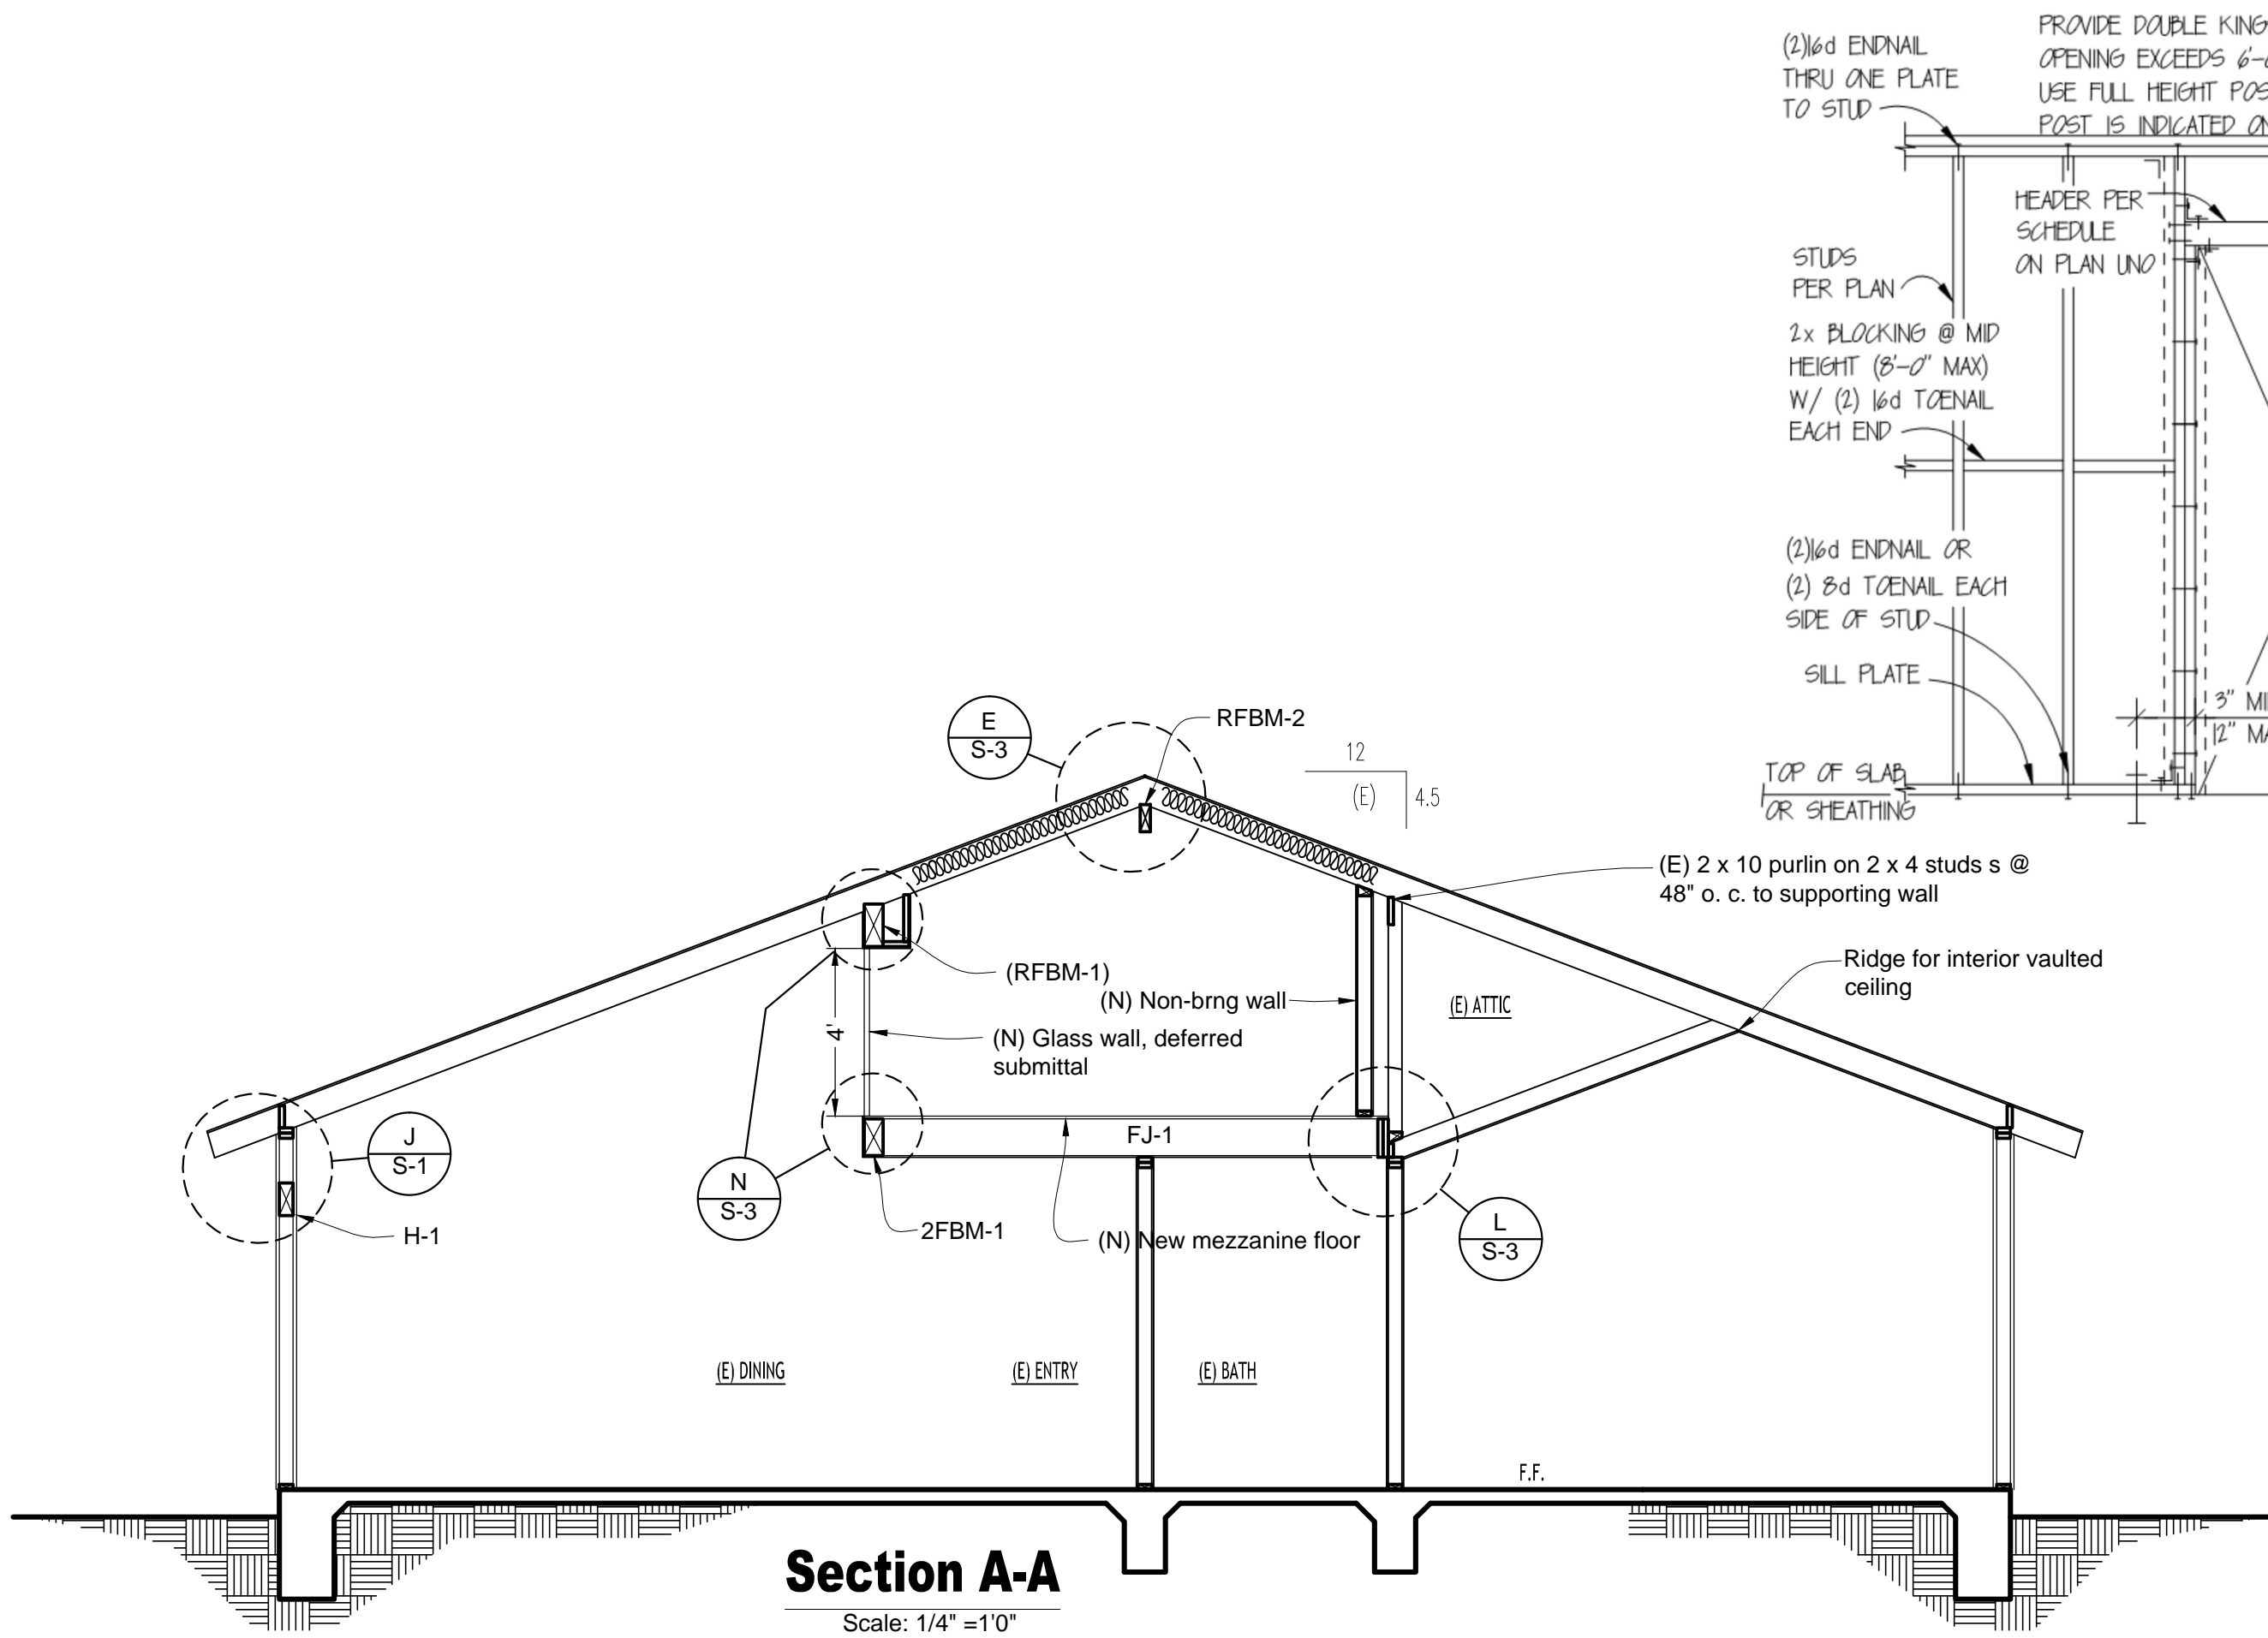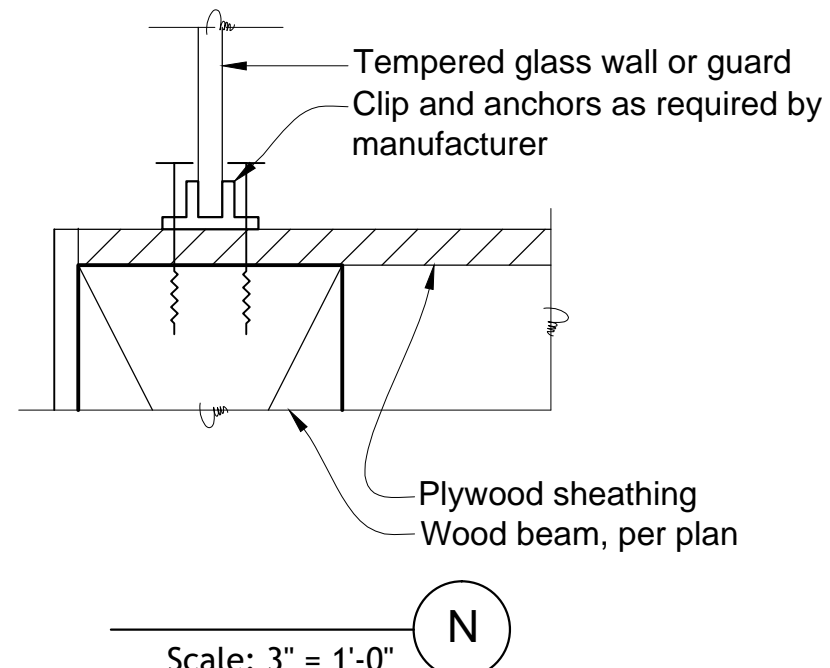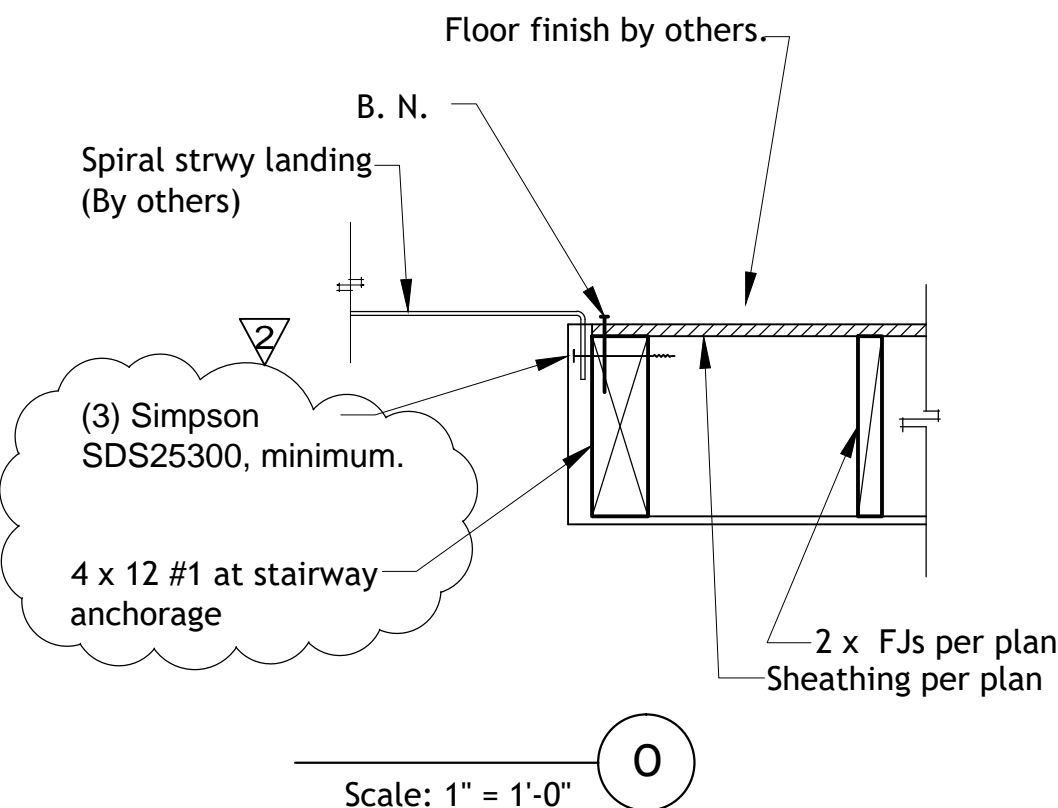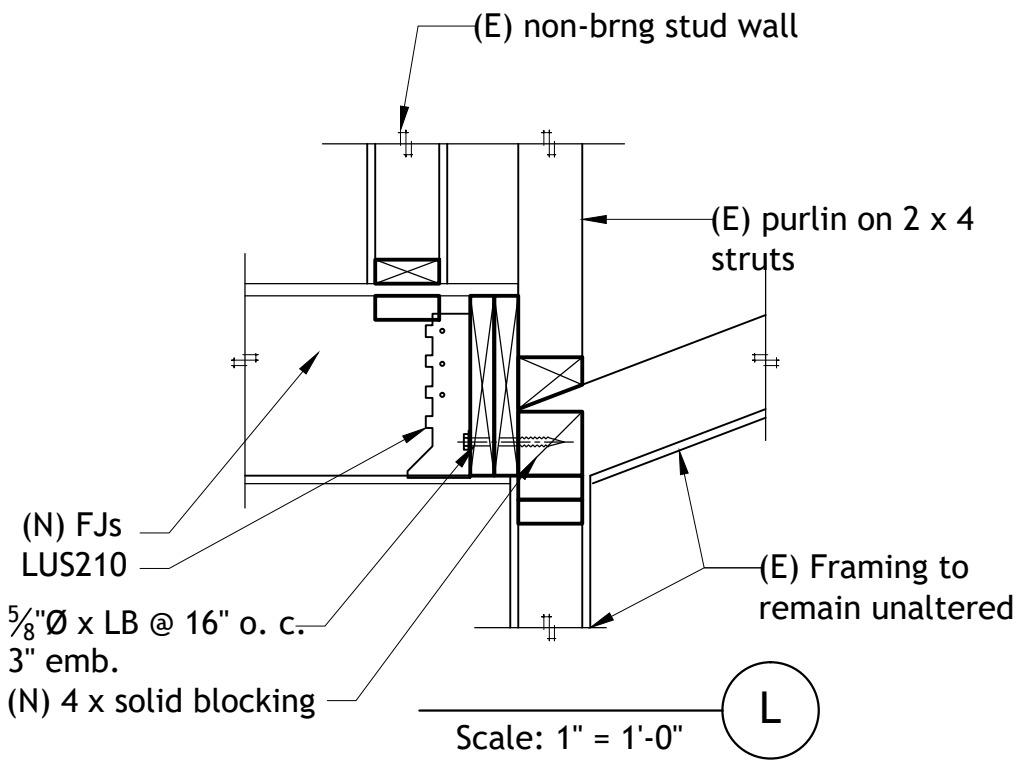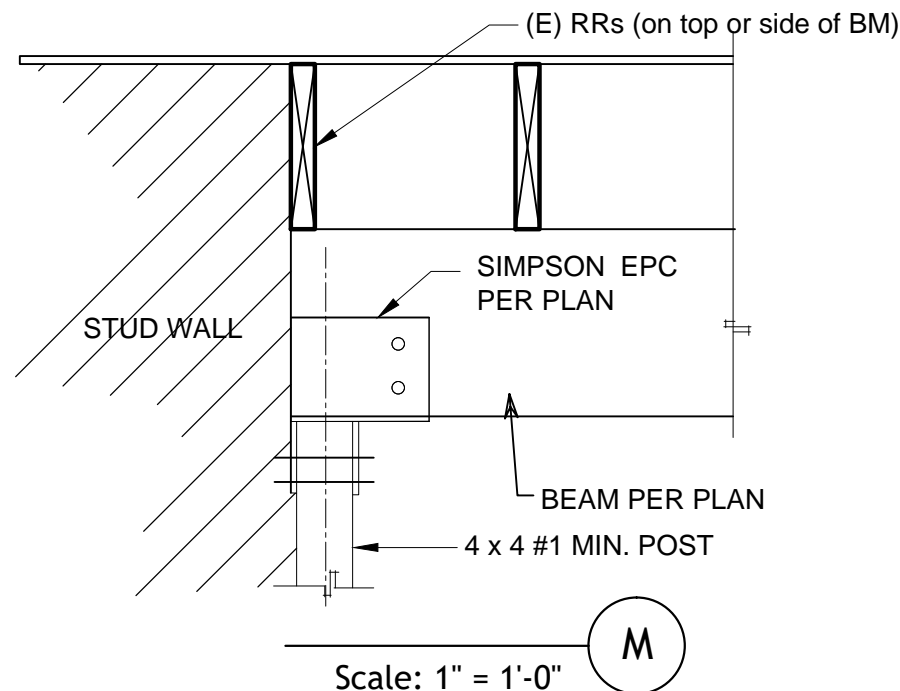


- Notes:
1. Framing at adjoining panel edges shall be 3 x or wider and nails shall be staggered where nails are spaced 2" on center.
 2. Where plywood is applied on both sides, and nail spacing is less than 6" o. c. on either side, panel joints shall be offset to fall on different framing memners, or framing shall be 3 x or thicker, and nails on each side shall be staggered.
 3. Framing at adjoining panel edges shall be 3 x or wider and nails shall be staggered where 10d nails having a penetration of more than 1-5/8" are spaced 3" or less on center.
 4. Minimum dimension of any plywood piece shall be 24". 1/2" minimum nail edge distance is required.
 5. Use common nails, only.

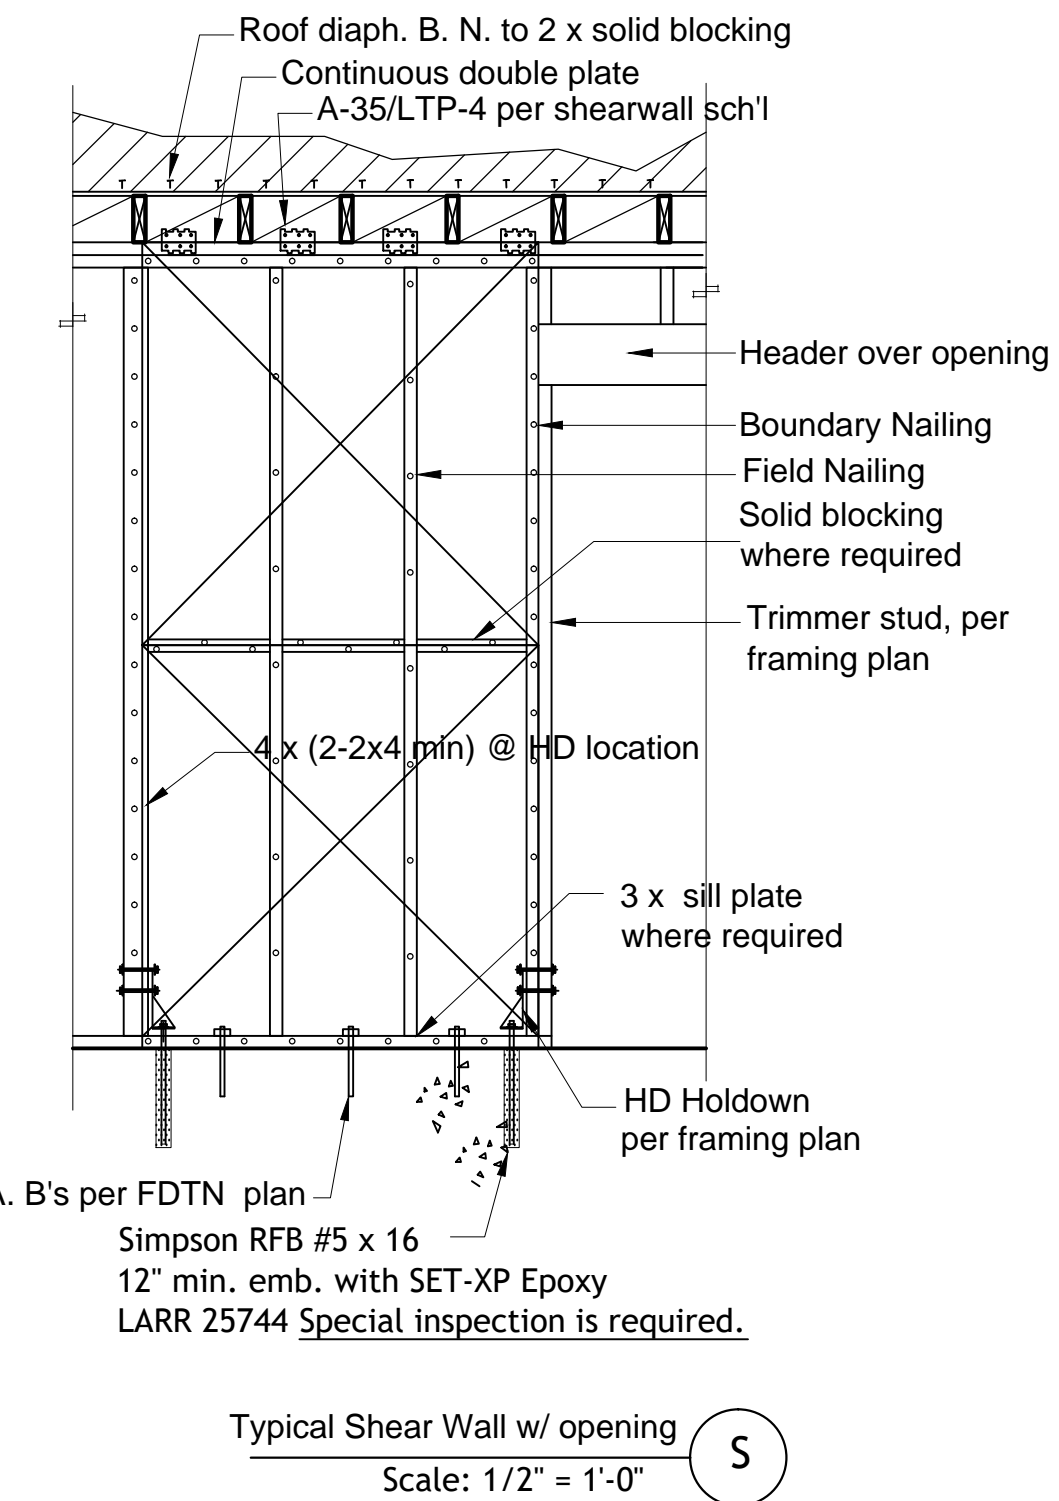

DATE	BY	DESCRIPTION
030120	CV	City review
042020	CV	Plan check corrections
062320	CV	Plan check corrections

9234 Stamps Ave.
Downey, CA 90240
Tel (323) 236-7210
vegacpe@aol.com
Lic. No. C43117

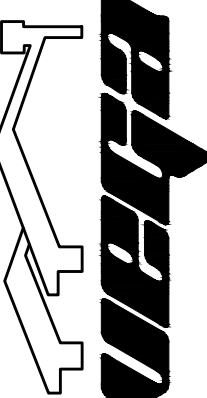

Cayetano, P.E., Inc.
Professional Practice of Engineering

SHEET TITLE:	STRUCTURAL ROOF FRAMING PLAN
ADDRESS:	24722 Jeremiah Drive Dana Point, CA 92629
OWNER/CONTRACTOR:	

PROJECT NO.	19-180
SHEET	S-3
OF	4 SHEETS

Δ	Panel Type ⁴	Nailing ⁶	Sole Pl Connectors	Block to Dbl Pl @ ⁹ top	A. B.'s to Fling ^{1,5,7}	allowable (pH) ^z
1 ²	^{1,5,6} STR 1 Plywd For panel on 2 sides use	8d @ 6", 6", 12"	20d @ 8" o.c.	LTp4 @ 24" o.c.	% 0" @ 40" o.c.	210
2 ²	^{1,5,6} STR 1 Plywd For panel on 2 sides use	8d @ 6", 6", 12"	^{1,5,6} 10" x 6" SDS @ 6" o.c.	LTp4 @ 16" o.c.	% 0" @ 24" o.c.	420 ²
2	^{1,5,6} STR 1 Plywd For panel on 2 sides use	8d @ 4", 4", 12"	20d @ 6" o.c.	LTp4 @ 16" o.c.	% 0" @ 32" o.c.	320 ²
3	^{1,5,6} STR 1 Plywd For panel on 2 sides use	8d @ 4", 4", 12"	^{1,5,6} 10" x 6" SDS @ 4" o.c.	LTp4 @ 8" o.c.	% 0" @ 16" o.c.	640
4	^{1,5,6} STR 1 Plywd 1/2" stucco	8d @ 3", 3", 12"	^{1,5,6} 10" x 6" SDS @ 8" o.c.	LTp4 @ 16" o.c.	% 0" @ 24" o.c.	500
4	^{1,5,6} STR 1 Plywd 1-1/2", 11 GA "	1-1/2", 11 GA "	20d @ 8" o.c.	LTp4 @ 24" o.c.	% 0" @ 60" o.c.	900

NOTES:

- 1) Element spacing shown on foundation plans govern over what is shown on table.
- 2) Where shear design values exceed 350 plf, all framing members receiving edge nailing from abutting panels shall not be less than a single 3-inch nominal member, or two 2-inch nominal members fastened together in accordance with Section 2306.1, to transfer the design shear value between framing members. Wood structural panel joint and sill plate nailing shall be staggered at all panel edges.
 - a) 1/2" edge distance for plywood boundary nailing
 - b) stagger nailing if nail spacing is less than 2" o. c.
 - c) square plate washers shall be used with all anchor bolts per CBC 2308.3.2
- 3) Nails shall have 7/16" head, with 1/4" thick furring, nailed to the wood studs. Staples are not allowed for structural applications.
- 4) Plywood shall be installed under 2 layers of 15# felt paper, when under stucco.
- 5) On existing footings use Simpson RFB's between existing bolts to provide the required spacing. Epoxy type:
Use Simpson SET-XP
- 6) Nails shall be common, only.
- 7) Foundation anchor bolts shall include 0.229" x 3" x 3" steel plate washers per CBC sect. 2308.12.8.
- 8) LARR 25427
- 9) Install hardware on alternate sides of wall when less than 12" o. c. spacing

Table 2: Holddown / Anchorage

HD symbol	HD type	Capacity,		Anchor (on conc. flng)	Min. embed ¹ /l
		4 x Post			
①	HDU2-SDS2.5 ²	2550		SSTB16 ^{5,7}	12-5/8"
②	HDU4-SDS2.5 ²	3325		SSTB24 ^{5,7}	20-5/8"
③	HDU5-SDS2.5 ²	3325		SSTB24 ^{5,7}	20-5/8"
④	HDU8-SDS2.5 ²	6970		SSTB28 ^{5,7}	24 7/8"
HD symbol	HD type	Capacity, 4 x Post	Nails No. req'd ea. end ⁶		
⑤	CMST16 ³	4585	56 Sinker		
⑥	CMST14 ³	6490	78-10d		
⑦	CMST12 ³	9215	98-10d		

NOTES:

- 1) Holdown hardware shall be secured in place prior to foundation inspection.
- 2) Holdown connector bolts into wood framing require approved plate washers.
- 3) Holdown connector bolts shall be tightened prior to covering the wall framing.
- 4) LARR 25720, ESR-2330
- 5) ER-4935
- 6) Contractor to provide the number of nails specified at each end of holdown.
- 7) Min. compressive strength is 2500 psi.
- 8) LARR 25713

JOIST TO SILL OR GIRDER, TOENAIL.....	3-8d
BLOCKING TO JOIST, TOENAIL EACH END.....	2-8d
JOIST TO BLOCKING, END NAIL.....	16d TOP & BOTTL
RIM JOIST TO JOISTS, END NAIL.....	16d TOP & BOTTL
FLOOR JOIST LAP & BEARING, FACE NAIL.....	2-16d
SOLE PLATE TO JOIST OR BLOCKING, FACE NAIL.....	16d @ 24" O.C.
STUD TO STUD PLATE, END NAIL.....	2-16d
STUD TO SOLE PLATE.....	4-8d TOENAIL
DOUBLE STUDS, FACE NAIL.....	OR 2-16d END
DOUBLE TOP PLATES, FACE NAIL.....	NAIL
TOP PLATES, LAPS AND INTERSECTIONS, FACE NAIL.....	16d @ 24" O.C.
CEILING JOISTS TO PLATE, TOENAIL.....	16d @ 24" O.C.
CEILING JOISTS, LAP OVER PARTITIONS, FACE NAIL.....	2-16d
CEILING JOISTS TO PARALLEL RAFTERS, FACE NAIL.....	3-8d
RAFTER TO PLATE, TOENAIL.....	3-16d
RAFTER TO RIDGE.....	3-16d
RAFTER TIES, 2x LUMBER, FACE NAIL.....	3-8d
RAFTER TIES, 1x LUMBER, FACE NAIL.....	2-16d
BUILT-UP CORNER STUDS.....	3-16d
POST TO PIER PAD, TOENAIL.....	5-8d
GIRDER TO POST, TOENAIL.....	16 @ 24" O.C.
2x PLANKS.....	3-16d
NOTES.....	3-16d
1. COMMON OR GALVANIZED BOX NAILS MAY BE USED.....	2-16d

NOTES

1. COMMON OR GALVANIZED BOX NAILS MAY BE USED.
2. SCHEDULE BASED ON DOUGLAS FIR-LARCH FRAMING.
3. TABLE BASED ON UBC TABLE 25-Q AND L.A. CITY TYPE V SHEET.
4. THESE CONNECTIONS ARE MINIMUM CONDITIONS AND MAY BE SUPERSEDED BY MORE SPECIFIC DETAILS AS INDICATED ON
5. THESE PLANS.
6. DIAPHRAGM SHEATHING NAILS OR OTHER APPROVED SHEATHING CONNECTORS SHALL BE DRIVEN SO
7. THAT THEIR HEAD OR CROWN IS FLUSH WITH THE SURFACE OF THE SHEATHING.

NAILING SCHEDULE

GENERAL REQUIREMENTS

- A. These documents are intended to provide sufficient information for the contractor to properly calculate the material, equipment and labor necessary for proper execution and completion of the project.
- B. Should any conditions arise where the intent of the drawings is in doubt, where there is a discrepancy, there appears to be in error on the drawings, or there is a discrepancy between the drawings and field conditions, the engineer of record shall be notified as soon as possible for the procedure to be followed.
- C. The structure is designed as a completely finished structure. The contractor is responsible for all other stages of construction. The design, adequacy and safety of erection bracing, shoring, safety measures, temporary supports, etc., is the sole responsibility of the contractor, and has not been considered by the engineer. The contractor is responsible for the stability of the structure prior to erection of all shear walls, roof and floor diaphragms. Vega Ceyetano, P. E., Inc. disclaims any liability or expense arising from any accident or structural failure during construction.
- D. It shall be the responsibility of the contractor to locate all existing utilities, whether shown hereon or not and to protect them from damage. The contractor shall bear all expense of repair or replacement in conjunction with the execution of this project.
- E. No changes are to be made on these plans without the knowledge and consent of the engineer whose signature appears hereon. Do not scale plans.
- F. All work shall comply with applicable state statutes and all regulations of other agencies having jurisdiction over this project. The contractor shall assume full responsibility for complying with the General Safety orders of the California Division of Industrial Safety, the regulations of the Federal and State Occupational Safety and Health administration. The contractor shall be responsible and hold harmless the engineer for any damages and/or penalties resulting from his failure to comply with said laws, statutes, ordinances and regulations.

MATERIAL SPECIFICATIONS

All materials and workmanship shall conform to the California Building Code 2019 Edition.

Lumber:

- Lumber shall be Douglas Fir per Standard Grading and Dressing rules No. 16 by the West Coast Lumber Inspection Bureau. 19% maximum moisture content. Must be grade marked.
- The following minimum grades shall apply:
 - Structural light framing #2
 - Structural Joist and Planks #2
 - Beams, Stringers, Posts and Timbers #1
- Lumber in contact with concrete or masonry shall be minimum 2 x sill pressure treated lumber in compliance with FS TT-W-591C or foundation grade redwood.
- Structural laminated beams shall be Parallam® PSL, as manufactured by Weyerhaeuser. Materials shall comply with ICC ES ESR-1387.
- Open web Joists shall be those manufactured by Truss-Joist Macmillan and shall be installed per manufacturer's specifications.
- Prefabricated connectors shall be as manufactured by Simpson Company "Strong Tie" connectors.
- Roof Sheathing: 1/2" Structural 1 Plywood w/ 8d Common nails @ 6" b'c, 12" max spacing. Specs of plan govern.
- Floor Sheathing: 3/4" T & G plywood with 10d @ 6" b'c, 12" max. Spacing shown on plan governs.

Concrete

- All concrete shall be 150 pcf density and shall attain a minimum compressive strength at 28 days on 4500 psi with W/C of 0.45.
- Concrete for grade beams and caissons shall be a minimum of 4500 psi compressive strength. Special inspection is required.
- Cement shall be type V Portland Cement per A.S.T.M. C-150. Maximum water content 7.5 gallons per sack of cement.
- Maximum aggregate size shall be 1-1/2".
- All concrete work shall conform to the A.C.I. 318 requirements for reinforced concrete and the A.C.I. 301 specifications and any applicable modifications as noted in these drawings and specifications.
- Reinforcing, anchor bolts, and all other embedded hardware shall be securely fastened and shall be inspected by city inspector prior to pouring concrete.
- Concrete shall be maintained in a moist condition for a minimum of seven days after its placement.

Reinforcing

- Reinforcing steel shall be deformed bars of intermediate grade conforming to ASTM Specification A615 grade 40 for bars #4 and smaller; A615 grade 60 for bars #5 and larger. Mesh reinforcing shall be 6 x 6 - W1.4 x W1.4 unless shown otherwise, conforming to ASTM specification A185.
- Provide minimum cover over reinforcing as follows:
 - a. Concrete against earth, unformed: 3"
 - b. Concrete against earth, formed: 2"
 - c. Concrete Block 2"
- Lap all reinforcing 30 diameters in concrete and 40 diameters in concrete block. Or, 24" minimum (concrete or block).

Masonry

- All concrete block shall be grade "A" load bearing units conforming to A.S.T.M. C-190, latest revision. f'm = 1500 psi. Continuous inspection is not required.
- Mortar mix shall be one part cement, 3-1/2 parts sand and a maximum of 1/4 part lime putty, or dry hydrated lime.
- Mortar joints shall be a minimum of 3/8" and shall be full head and bed.
- Grout mix shall be 1 part cement, 3 parts sand, 2 parts pea gravel, and sufficient water to cause the grout to flow without segregation. Minimum compressive strength shall be 2500 psi. in 28 days.
- Grout pours shall not exceed four feet in height. Fill all cells solid with grout.

Structural Steel

- Structural steel and miscellaneous iron shall conform to ASTM A 36.
- Steel tubes shall conform to ASTM A501. Steel pipe shall conform to A53 Grade "B".
- Machine bolts shall conform to ASTM A307, Grade A and ANSI B18.2. When indicated high strength required use ASTM A 325.
- All Welding shall be performed by certified welders under the supervision of a Registered Deputy Inspector or in the shop of an approved fabricator.
- Continuous inspection is required for field welding.
- A certificate of Fabrication from the shop performing the welding or a report from the Registered Deputy Inspector must be furnished to the job inspector prior to framing approval.
- Pipe columns: Use ASTM A 53, Grade B. Steel tubes shall conform to ASTM A500 grade "B" steel, Fy=46 ksi.
- Welding shall be done by electric shielded arc process using E-70XX electrodes. All welds shall be uniform in size and appearance, and free of pinholes, porosity, undercutting or other defects. All but welds shall be full penetration.
- Holes in steel shall be 1/16" oversize for ordinary steel to steel connections and 3/16" for anchor bolts, unless noted otherwise.
- Structural steel not encased in concrete or masonry shall be shop painted as specified. Any abrasion shall be touched up after erection.

Glulam Beams:

- All laminated lumber shall be properly kiln dried for glue lamination and moisture content shall not exceed 12%.
- Glu-lams shall conform to combination 24F: Fb = 2400 psi minimum,
- $F_v = 165 \text{ psi}$, $F_c (\text{perp}) = 650 \text{ psi}$ and $E = 1.8 \text{ E6 psi}$, minimum.
- All laminated beams shall conform to industrial appearance grade unless shown or specified otherwise.
- Tension lamination required at top & bottom of all cantilever glu-lam beams.

Soil bearing capacity, per code table 1806.A.2: 1500 psf.

Roof deck surface shall be finished with "Desert-Crete magnezite walking deck system" by Hill Brothers Chemical Company (or approved equal). ESR-1161, LARR 25262.


FOUNDATION NOTES

1. Footings to be continuous, poured in place in compacted natural grade. Depth of footing to be a minimum of 24 inches into natural undisturbed soil.
2. Slab to be 5 inches thick concrete reinforced with #4 @ 16" o. c. E/W over 10 mill vapor barrier.
3. Anchor bolts to be 5/8" with 7" minimum embedment into concrete. Minimum two anchor bolts per plate; one within 12" of plate end. Maximum bolt spacing to be 6'-0" o. c. Spacing specified on Foundation Plan governs.
4. When slabs and footings are poured over fill, fill must be compacted to at least 90% of maximum dry density.
5. Slabs to be connected to perimeter footings by 4 #4 dowels at 24" o. c., bent 3 ft. into slab.
6. Saturated soil 18" deep below placing the concrete slab.
7. All footings to be reinforced with continuous #4 bars. Two 3" from the bottom and two 1-1/2" from the top of footing.
8. Holdown hardware must be secured in place prior to foundation inspection.
9. Lumber in contact with concrete or masonry shall be minimum 2 x sill pressure treated lumber in compliance with FST T-W-591C or foundation grade redwood.
10. All planters in close proximity to the structure shall have adequate drainage of surface water to prevent saturation of soil under foundation.

7	NO.	DESCRIPTION	DATE:	BY:
①	City review		030120	CV
②	City corrections resubmittal		042020	CV
③	City corrections resubmittal		062320	CV

9234 Stamps Ave.
Downey, CA 90240
Tel (562) 861-5333
Fax (562) 861-5333
Lic. No. C43117

Cayetano, P. E., Inc.

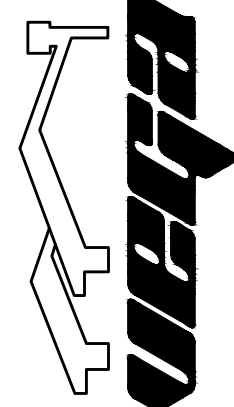

SHEET TITLE: GENERAL NOTES, SCHEDULES

ADDRESS:

OWNER/CONTRACTOR:

PROJECT NO. 19-180

SHEET
SD-1
OF 4 SHEETS

06/23/2020